


Section 28 Township 21 Range 5 E

Well No. # 1 Jensen

Company Mendenhall Drlg.

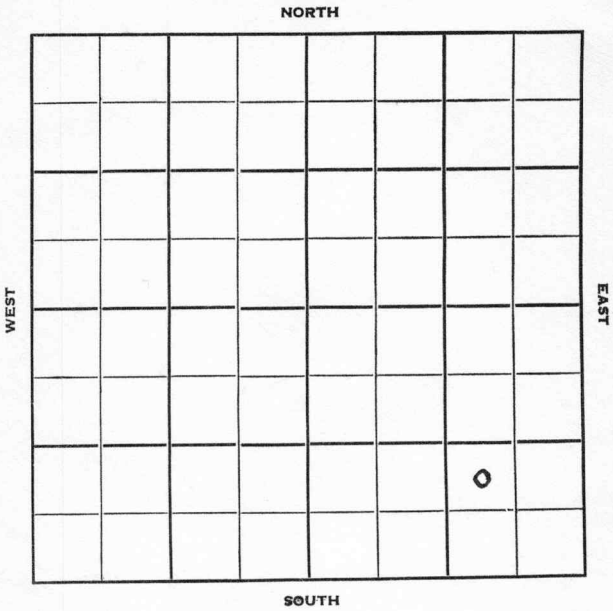

Marion

KANSAS

Sec. 28

Twp.

21

R.

5 E

1 Jensen

Well No. _____ Farm

Mendenhall Drlg.

Company

Mendenhall

Contractor

Ft. from N. Line

990


Ft. from S. Line

990

Ft. from E. Line

Ft. from W. Line

NW SE SE

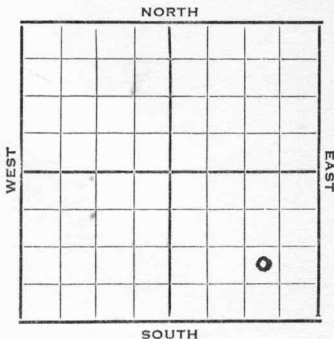

1952

Elev. 1417'

REPORT

4/9

RUR

4/23

Spud 4-13-52

D&A TD 2440'

8" @ 98'

KC 1725 Miss 2280

Kh. 2296 Viola 2428-40 TD

D&A

ABANDONED

