


Section 28 Township 21 Range 4E

Well No. #1 Peterson

Company Fell & Wolf

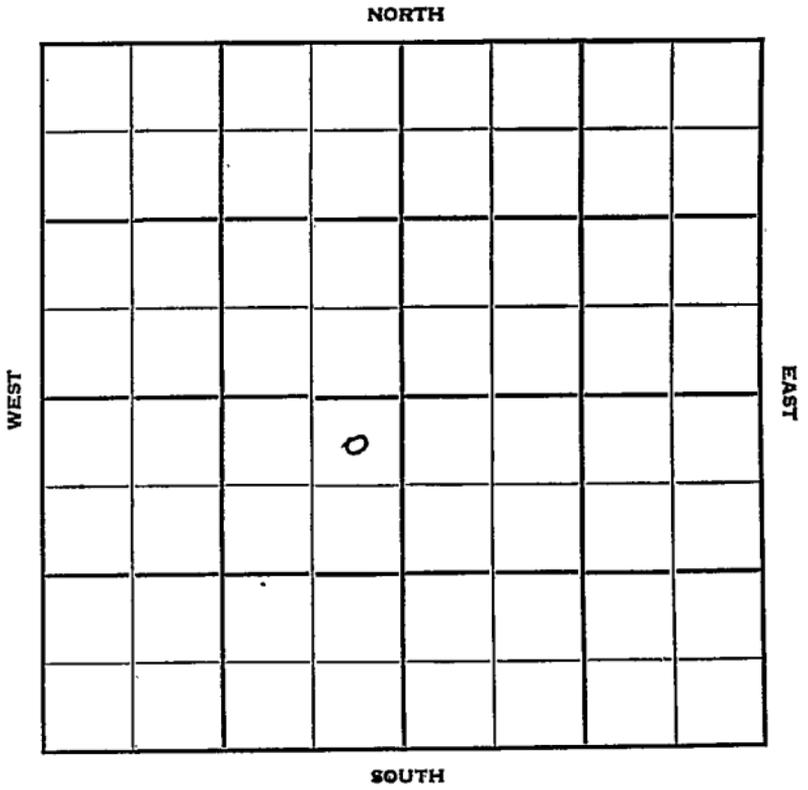

Marion

KANSAS

Sec. 28 Twp. 21 R. 4 E

Well No. # 1 Peterson Farm

Fell & Wolf Company

Uhl Drlg. Contractor


330 Ft. from N. Line

_____ Ft. from S. Line

330 Ft. from E. Line

_____ Ft. from W. Line

NE NE SW (old wells
abd)

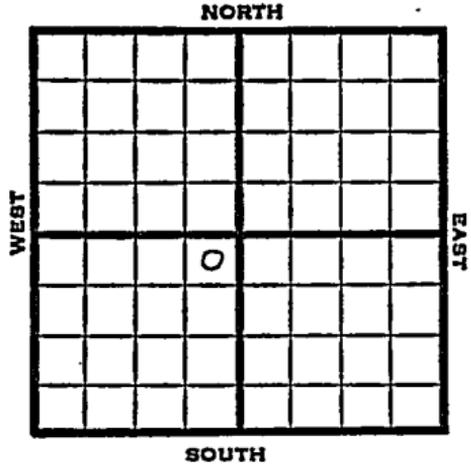

1951

Elev. 1377' REPORT

4/4

Spud 3-31-51
8" @ 110

4/18

Spud 3-31-51
D&A TD 2460 $\frac{1}{2}$
8" @ 110
Hunton 2437-40
5" @ 2437 TD 2449
10 go 12 hr 300 A
no inc. Maq 2443
Viola 2457-60
B/ $\frac{1}{2}$ bailer oil HFW
D&A

ABANDONED

