


Section 28 Township 21 Range 4E

Well No. 1 Covert "A"

Company G R A

Sellers Pool

NORTH

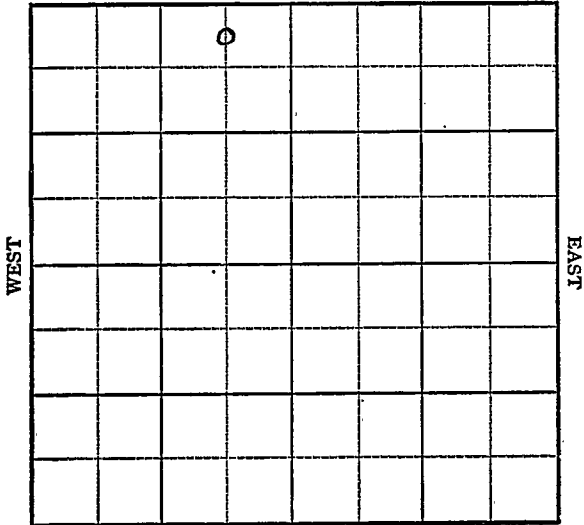

SOUTH

Sec. 28 Twp. 21 R. 4E

Well No. #1 Covert "A" Farm _____

C R A


Company _____

230' Ft. from N. Line

_____ Ft. from S. Line

660' Ft. from E. Line

_____ Ft. from W. Line

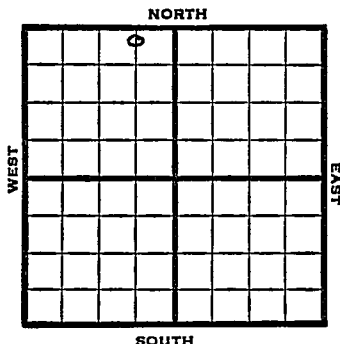

C N L NE NW

1948 Eli 1304' REPORT

- 10/27 8" @ 82'
- 11/3 Drlg 2260'
- 11/10 Lansing 1673'
- Chat 2163
- Kinderhook 2188'
- Naguoketa 2337-44'
- TD 2344'
- 5"@ 2344'
- 11/16 Viola 2360'
- TD 2364'
- 11/23 250 acid
- TD 2365'
- 250 acid
- 12/1 TD 2365'
- Viola 2360'
- 5"@ 2344'
- 1000 acid
- Pump 35 oil / 10 W Pot
- 36° Gr.
- Comp

COMPLETED

Map No. _____ Sec. 28 Twp. 21 R. 4E

Well No. 1 Covert "A"

C R A _____ Company

FIRST REPORT _____ Contractor

C N L NE NW

SECTION PLAT

230 Ft. from N. Line

_____ Ft. from S. Line

660 Ft. from E. Line

_____ Ft. from W. Line

	0		

Marion County

Location _____

Rig up _____

Drilling and Remarks:

8" @ 82

RECORD

Cased _____ in., _____ ft.

Sand _____

Gas _____

Oil _____

Total Depth _____

PRODUCTION

1st 24 hrs. Nat. _____

1st 24 hrs. after shot _____

Gas _____ Cu. Ft.

Dry Hole _____

Abandoned _____

Date

OCT 27 1948 19

S. J. LEWIS Scout

Map No. 23 Sec. 28 Twp. 21 R. 4E

Well No. 1 Covert "A"

C R A Company

COMPLETE Contractor
C N L NE NW E1,1304

SECTION PLAT

	0		

330 Ft. from N. Line

 Ft. from S. Line

660 Ft. from E. Line

 Ft. from W. Line

Marion County

Location

Rig up

Drilling and Remarks:

VW 2860
5" @ 2344
1000 @ 2100
Pump 35 oil 410W
BJ
86 @ 2100

RECORD

Cased in., ft.

Sand

Gas

Oil

Total Depth 2365

PRODUCTION

1st 24 hrs. Nat.

1st 24 hrs. after shot

Gas Cu. Ft.

Dry Hole

Abandoned

Date

DEC 1 1948

19

S. J. LEWIS Scout