
FORM 51 25M 8-50 WESTERN Marion KANSAS

Section 28 Township 21 Range 4E

Well No. #3 Stovall "A"

Company Feld & Wolf

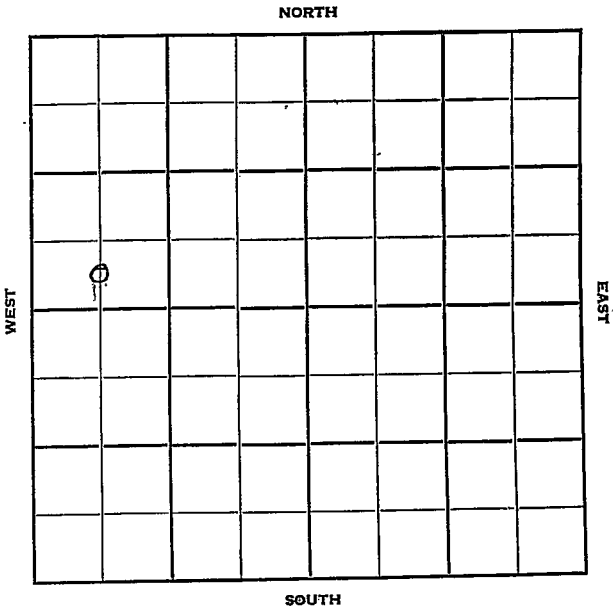

FORM 252-B'
10M 8-51 TPCO.

Marion KANSAS

Sec. 28 Twp. 21 R. 4E

Well No. #3 Stovall "A" Farm

Feld & Wolf Company

H & M Drlg. - Contr. Contractor


Ft. from N. Line

330' Ft. from S. Line

Ft. from E. Line

660' Ft. from W. Line

C S L SW NW

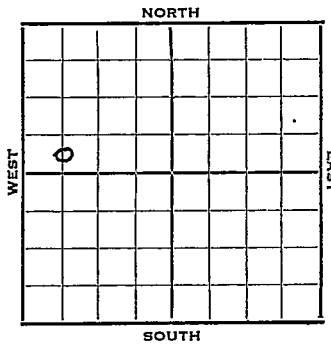

1951	Elev. 1382' REPORT
11/21	Cellar & Pits
12/19	Oil well TD 2454' Miss 2252' Viola 2424' 5" @ 2424' TD 2449' FU 1000' oil 140' water 36 hr. TD 2454' Comp. 12 BOPD **COMPLETED**

FORM 275 FOR SALE BY KANSAS BLUE PRINT CO.


County Marion State Kansas

Sec. 28 (Blk. Twp.) 21 (Sur. Rge.) 4E Map No.

Operator Feld & Wolf

Well No. 3 Farm Stovall "A"

Elev. Location C S L SW NW

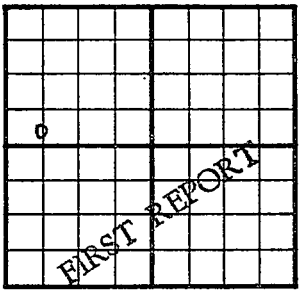

330' Ft. From S Line NW

660 Ft. From W Line Quarter

1st. Report NOV 21 1951

Completion

Remarks

H & M Drlg. - Contr.

Spudding Date

Drlg. Data

Cellar & pits

J. E. TYRA

FORM 275 FOR SALE BY KANSAS BLUE PRINT CO.


County Marion State Kansas

Sec. 28 (Blk. Twp.) 21 (Sur. Rge.) 4E Map No.

Operator Feld & Wolf

Well No. 3 Farm Stovall "A"

Elev. 1382 Location C S L SW NW

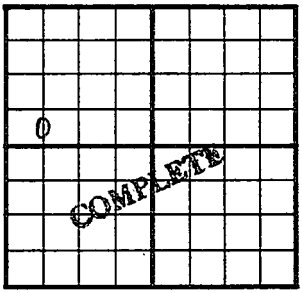

330 Ft. From S Line NW

660 Ft. From W Line Quarter

1st. Report

Completion DEC 1 9 195?

Remarks

H & M Drlg. - Contr.

Spudding Date

Drlg. Data Oil well TD 2454

Miss 2252 Viola 2424 5" @ 2424

TD 2449 FU 1000' oil 140' water 36 hr.

TD 2454 Comp. 12 bopd

J. E. TYRA