


Section 29 Township 21 Range 4E

Well No. #2 Stovall

Company H. J. Uhl

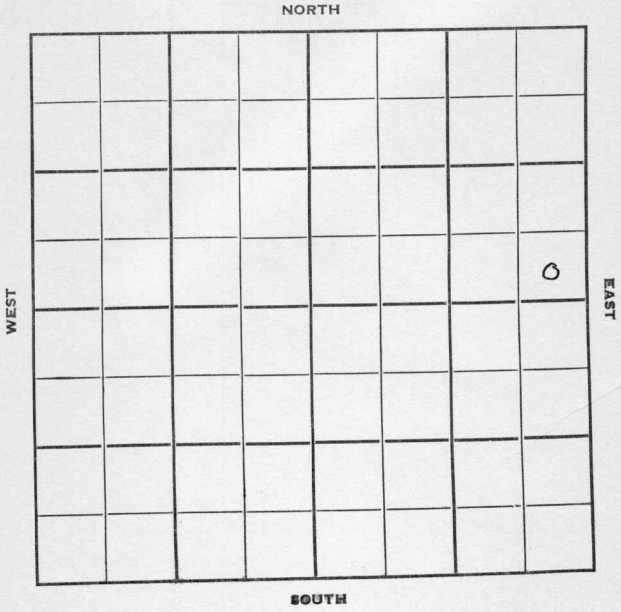

Sec. 29 Twp. 21 R. 4 E

Well No. # 2 Stovall Farm

H. J. Uhl Company

Uhl Contractor

Sellers Pool


Ft. from N. Line

330 Ft. from S. Line

330 Ft. from E. Line

Ft. from W. Line

SE SE NE

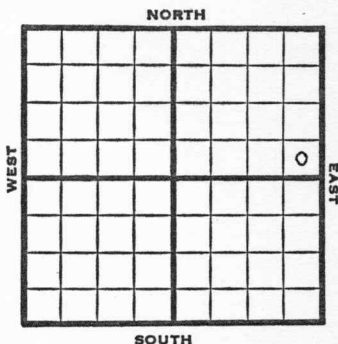

1951

Elev. 1377'

REPORT

8/8

Spud 8-3-51  
8" @ 95  
Drlg. 400'

8/29

Spud 8-3-51  
Oil well TD 2426' 8" @ 95  
Top. 1154' Heeb 1488' Lans. 1746'  
B KC 2087' Cong. 2240' Kh. 2290'  
Misener 2418' Hunton 2422'  
TD 2426' 4 1/2" @ 2414 CO to 2416  
HFO CO to 2426' S/20 BOPH  
Comp. 50 BOPD

COMPLETED

County Marion State Kansas

Sec. 29 (Blk. 21) (Sur. Rge.) 4E Map No.

Operator H. J. Uhl

Well No. 2 Farm Stovall

Elev. \_\_\_\_\_ Location SE SE NE

FIRST REPORT									

330 Ft. From S Line NE

330 Ft. From E Line Quarter

1st. Report AUG 8 1951

Completion \_\_\_\_\_

Remarks \_\_\_\_\_

Uhl - Contr.

Spudding Date 8-3-51

Drlg. Data Sellers Pool

8" @ 95 drlg. 400

J. E. TYRA

County Marion State Kansas

Sec. 29 (Blk. 21) (Sur. 4E) (Twp.) (Rge.) Map No.

Operator H. J. Uhl

Well No. 2 Farm Stovall

Elev. 1377 Location SE SE NE


**COMPLETE** 0

330 Ft. From S Line NE

330 Ft. From E Line Quarter

1st. Report

Completion AUG 29 1951

Remarks Sellers Pool

Uhl - Contr.

Spudding Date 8-3-51

Drlg. Data Oil well TD 2426

8" @ 95 Top. 1154 Heeb. 1488 Lans. 1746

B KC 2087 Cong. 2240 Kh. 2290

Misener 2418 Hunton 2422 TD 2426

4 1/2" @ 2414 CO to 2416 HFO CO to 2426

8/ 20 boph Comp. 50 bopd

J. E. TYRA