


Section 29 Township 21 Range 4E

Well No. #1 Slocum

Company Greeley Drlg., Inc.

NORTH

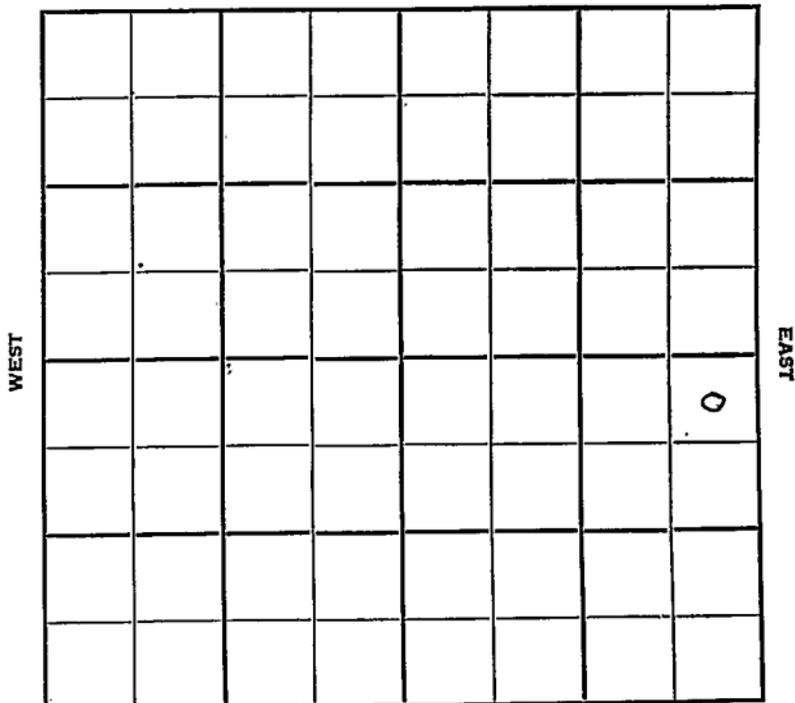

SOUTH

Sec. 29 Twp. 21 R. 4 E ✓

Well No. # 1 Slocum Farm

Greeley Drlg. Inc. Company

Contractor

Covert-Sellers Pool


330 Ft. from N. Line

Ft. from S. Line

330 Ft. from E. Line

Ft. from W. Line

NE NE SE (Twin well)

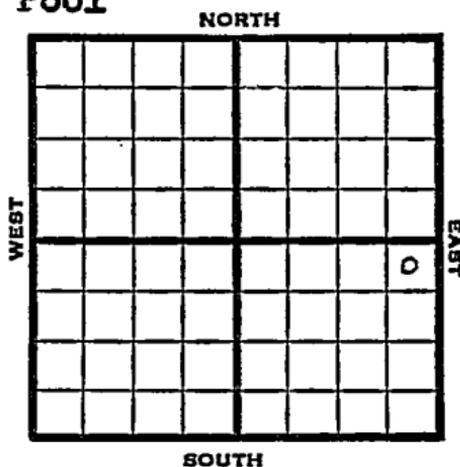

1951 Elev. 1376' REPORT

6/6 Surface Pipe

7/11 Spud 6-9-51

Oil well TD 2432' 8" @ 98'
 Lans. 1757' Miss 2252' Kh. 2286'
 Viola 2428' TD 2432'
 DST 2427-32 open 1/2 hr. rec 210' oil
 & 5' mud 5" @ 2428' FU 1642'
 oil overnite
 Comp. 100 BOPD

COMPLETED

County Marion State Kansas

Sec. 29 (Blk. Twp.) 21 (Sur. Rge.) 4E Map No.

Operator Greeley Drlg. Inc.

Well No. 1 Farm Slocum

Elev. _____ Location NE NE SE (twin well)

FIRST REPORT

330 Ft. From N Line SE

330 Ft. From E Line Quarter

Ist. Report JUN 6 1951

Completion _____

Remarks _____

Spudding Date _____

Drlg. Data Covert - Sellers Pool

surface pipe

J. E. TYRA


County Marion State Kansas

Sec. 29 (^{Blk.}_{Twp.}) 21 (^{Sur.}_{Rge.}) 4E Map No.

Operator Greeley Drlg.

Well No. 1 Farm Slocum

Elev. 1376 Location NE NE SE

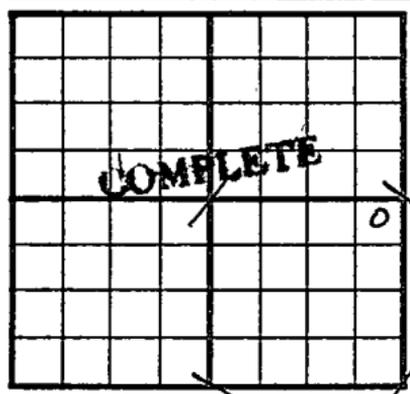

330 Ft. From N Line SE

330 Ft. From E Line Quarter

Ist. Report

Completion JUL 11 1951

Remarks Covert-Sellers Pool

Spudding Date 6-9-51

Drlg. Data Oil well TD 2432

8" @ 98 Lans. 1757 Miss. 2252

Kh. 2286 Viola 2428 TD 2432

DST 2427-32 open 1/2 hr. Rec. 210'

oil & 5' mud 5" @ 2428 FU 1642'

oil overnite Comp. 100 bopd

J. E. TYRA