


Section 29 Township 21 Range 1E

Well No. 2 Slocum

Company Greeley Drlg.

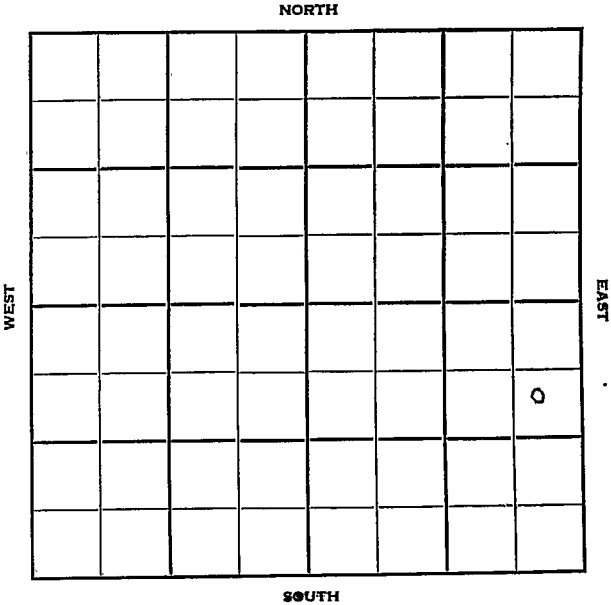

Sec. 29 Twp. 21 R. 4E

Well No. #2 Slocum Farm

Greeley Drlg. Company

Greeley Drlg. - Contr. Contractor

Sellers Pool


990' Ft. from N. Line

Ft. from S. Line

150' Ft. from E. Line

Ft. from W. Line

SE NE SE

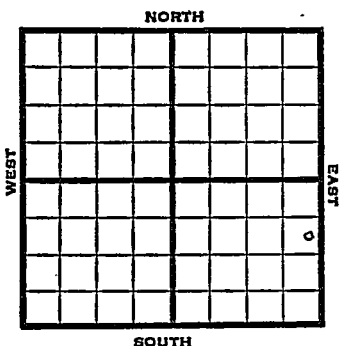

1951 Elev. - REPORT

8/1

8" @ 95'
Drlg. 1900'

8/15

D&A TD 2437
8" @ 95
Lans. 1749
Miss 2254
Kh. 2286
Hunton 2430-32
4 1/2" @ 2430
TD 2437
2 goph 24/2430-36 1000 A
FU 100' wtr 50' oil 10 hr.
D&A

ABANDONED

County Marion State Kansas

Sec. 29 (Blk. Twp.) 21 (Sur. Rge.) 4E Map No.

Operator Greeley Drlg.

Well No. **2** Farm **Slocum**

Elev.	Location	SE	NE	SE
-------	----------	----	----	----

990 Ft. From N Line SE

750 Ft. From E Line Quarter

1st. Report AUG 1 1951

Completion

Remarks

Greeley Drlg. - Contr.


Spudding Date

Drlg. Data	Sellers Pool
1	1
2	2
3	3
100	100

8" @ 95. drlg. 1900

J. E. TYRA

County Marion State Kansas
 Sec. 29 (Blk.
Twp.) 21 (Sur.
Rge.) 4 E Map No.
 Operator Greeley Drlg.
 Well No. 2 Farm Slocum
 Elev. Location SE NE SE

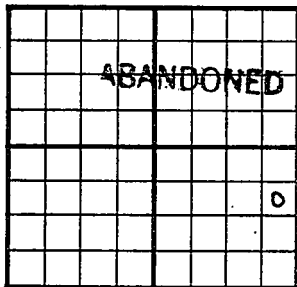

990 Ft. From N Line SE
150 Ft. From E Line Quarter

1st. Report

Completion AUG 15 1951

Remarks Sellers Pool
Greeley Drlg. - Contr.

Spudding Date

Drlg. Data D & A TD 2437

8" @ 95 Lans. 1749 Miss. 2254

Kh. 2286 Hunton 2430-32 4 $\frac{1}{2}$ " @ 2430

TD 2437 2 goph 24/ 2430-36 1000 A

FU 100' water 50' oil 10 hr.

D & A

J. E. TYRA