


Section 29 Township 21 Range 4E

Well No. #3 Slocum

Company Greeley Drlg.

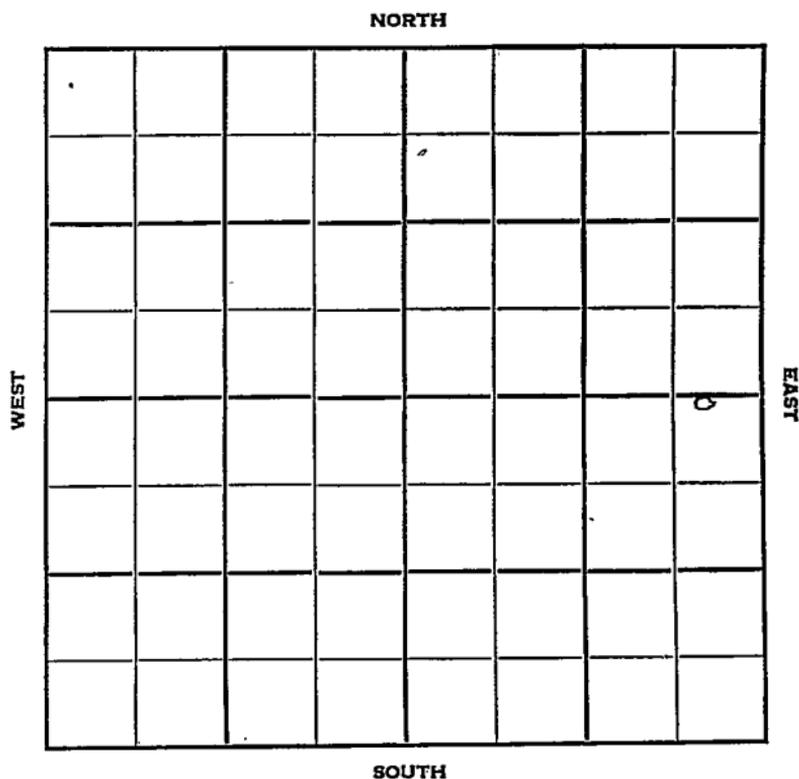

Marion

KANSAS

Sec. 29 Twp. 21 R. 4 E

Well No. # 3 Slocum Farm

Greeley Drlg. Company

Contractor

Sellers Pool


50 Ft. from N. Line

Ft. from S. Line

380 Ft. from E. Line

Ft. from W. Line

NE NE SE

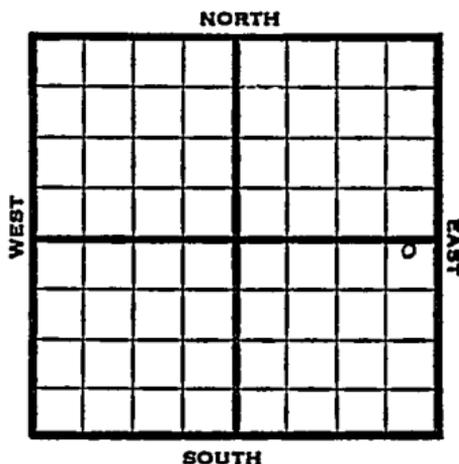

1951 Elev. 1377' REPORT

9/12 R U R

10/3 Spud 9-15-51
 Oil well TD 2427' 8" @ 101
 Lans. 1756' Miss 2249' Kh. 2273'
 Misenor 2420' Hunton 2423-27'
 4 1/2" @ 2415 TD 2427' FU 600' oil
 2 hr.
 Comp. 60 BOPD

COMPLETED

