


Map No. **KANSAS** Sec. **29** Twp. **21** R. **12 E**
 Well No. **1-A Houghton** Farm
A. M. Landon Company

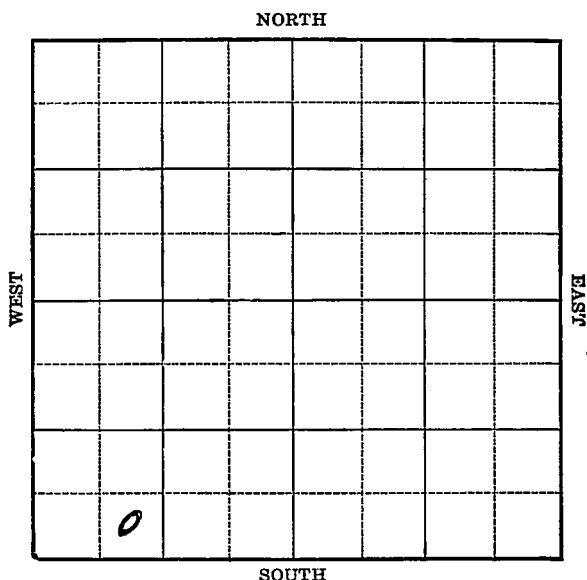

Location _____

Drilling Remarks _____

Rig Up _____

Drilling Remarks _____

RECORD

Cased _____ in. _____ ft.

Sand _____

Gas _____

Oil _____

Total Depth _____

PRODUCTION

1st 24 hrs. Nat. _____

1st 24 hrs. after shot _____

Gas _____ cu. ft. _____

Dry Hole _____


Abandoned _____

Lyon

Map No. KANSAS Sec. 29 Twp. 21 R. 12E

Well No. 1-A Houghton Farm
A. M. Landon Company

 Ft. from N. Line
330 Ft. from S. Line
 Ft. from E. Line
990 Ft. from W. Line

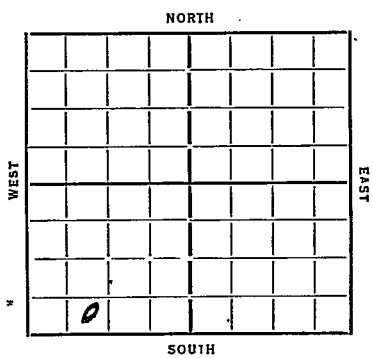

Date 1935

REPORT

5/15 Alg 500
5/25 780 sh
5/29
6/6 Alg 1045
6/13 " 1290
6/24 — 678 —
7/2 Shak 1860-90
 T 17 1910
 17A.

ABANDONED

Map No. 21 Sec. 29 Twp. 21 R. 12 EWell No. 1A-HoughtonG. M. Landon Company

Contractor

FIRST REPORTS

Ft. from N. Line

330 Ft. from S. Line

Ft. from E. Line

990 Ft. from W. Line

SECTION PLAT

Location

Rig up

Drilling and Remarks:

1029 500

RECORD

Cased in., ft.Sand Gas Oil Total Depth

PRODUCTION

1st 24 hrs. Nat. 1st 24 hrs. after shot Gas Cu. Ft.Dry Hole Abandoned

Date

ORVAL MANNSCHRECK

5-15-35 192 Scout

KANSAS

Map No. 21 Sec. 29 Twp. 21 R. 12 EWell No. 1A-HoughtonG. M. London Company

Contractor

ABANDONED

SECTION PLAT

Ft. from N. Line

330 Ft. from S. Line

Ft. from E. Line

990 Ft. from W. Line

Location

Rig up

Drilling and Remarks:

HD + FI

RECORD

Cased _____ in., _____ ft.

Sand 1860-90

Gas _____

Oil _____

Total Depth 1910

PRODUCTION

1st 24 hrs. Nat. _____

1st 24 hrs. after shot _____

Gas _____ Cu. Ft.

Dry Hole _____

Abandoned _____

Date

ORVAL MANNSCHECK

7-2-35 192 _____ Scout