

DX 78-1


Lyon KANSAS



Section 29 Township 21 Range 12E

Well No. 1 Houghton

Company Lotus Oil

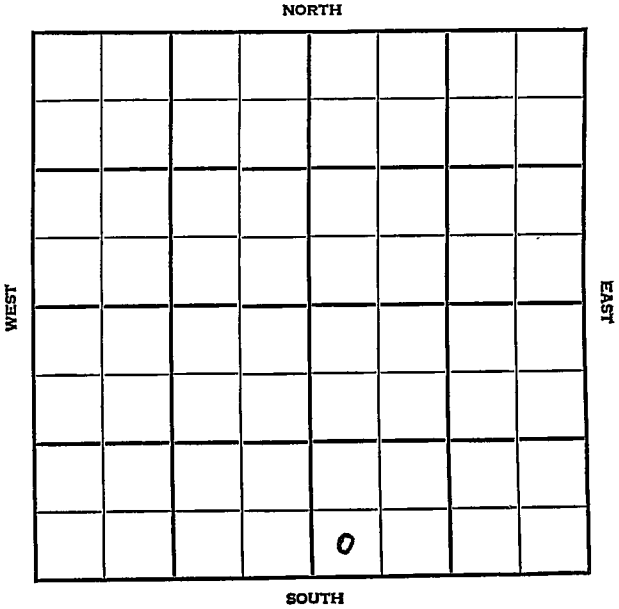

Lyon

KANSAS


SEC.	TWP.	R.
29	21	12 E

WELL NO. # 1 Haughton FARM

COMPANY Lotus Oil

CONTRACTOR Geneva Oil & Gas
Frankhauser Pool

_____ Ft. from N. Line
330 _____ Ft. from S. Line
_____ Ft. from E. Line
330 _____ Ft. from W. Line

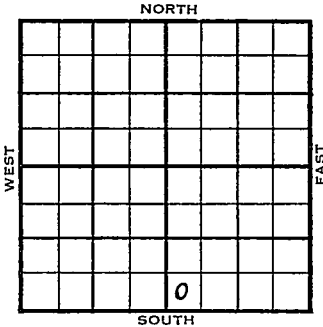

SW SW SE

	ELEVATION	REPORT
1954	-	

12/15 Spud 12-7-54
8" @ 50' Doug 867' Bart 1938
TD 1940' 4" @ 1938' WOCT

1955
3/2 Spud 12-7-54 - Oil Well
TD 1940'
8" @ 50'
Doug. 867', Bart. 1938'
TD 1940'
4" @ 1938'
CO to 1940' frac
C omp. 18 bopd

COMPLETED

