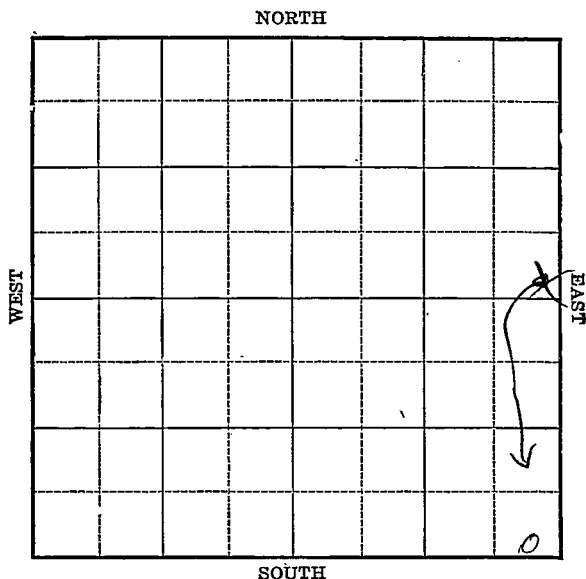


Map No. 1 Kane Sec. 29 Twp. 21 R. 12 *Lyons*Well No. 1 Houghton Farm
South Western Pet. Company

Location _____

Drilling Remarks _____

Rig Up _____

Drilling Remarks _____

RECORD

Cased _____ in. _____ ft.

Sand _____

Gas _____

Oil _____

Total Depth _____

PRODUCTION

1st 24 hrs. Nat. _____

1st. 24 hrs. after shot _____

Gas _____ cu. ft.

Dry Hole _____

Abandoned _____

*Lyon*Map No. *Kansas* Sec. *29* Twp. *21* R. *12*Well No. *1* *Houghton* Farm*South Western Pet* Company

NORTH


_____ Ft. from N. Line

250 Ft. from S. Line*250* Ft. from E. Line

_____ Ft. from W. Line

WEST

EAST

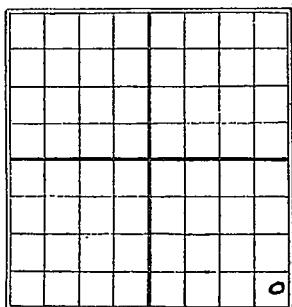

SOUTH

Date

REPORT

*1925**3/24 Rgn up**4/24 D + G 1990 H.F.W.*

Lyon

21 **KANSAS** Sec. 29 Twp. 21 R. 12

Well No. 1 *Houghton*

South Western Pet Company

Contractor

FIRST REPORT

SECTION PLAT

_____ Ft. from N. Line

250 _____ Ft. from S. Line

250 _____ Ft. from E. Line

_____ Ft. from W. Line

			0

Location _____

Rig up _____

Drilling and Remarks:

Rig up

RECORD

Cased _____ in., _____ ft.

Sand _____

Gas _____

Oil _____

Total Depth _____

PRODUCTION

1st 24 hrs. Nat. _____

1st 24 hrs. after shot _____

Gas _____ Cu. Ft.

Dry Hole _____

Abandoned _____

Date

3/24

192

M. A. BENEAR

Scout

21
 Map No. 124 Sec. 29 Twp. 21 R. 12E
 Well No. 1 Houghton
Peabody & Son Oil Co Company

Contractor

CORRECTION

SECTION PLAT

Ft. from N. Line

250

Ft. from S. Line

250

Ft. from E. Line

Ft. from W. Line

Location -----

Rig up -----

Drilling and Remarks: -----

July 985'

RECORD

Cased ----- in., ----- ft.

Sand -----

Gas -----

Oil -----

Total Depth -----

PRODUCTION

1st 24 hrs. Nat. -----

1st 24 hrs. after shot -----

Gas ----- Cu. Ft.

Dry Hole -----

Abandoned -----

Date

APR 10 1925

192

Chas. L. Sherwood
 Scout

CORRECTION
 chg location
 to Sec

Map No. 21 10622 Sec. 29 Twp. 21 R. 12
 Well No. 1 Houghton
Arthur W. Ben Ref Co Company

Contractor

COMPLETED

SECTION PLAT

Ft. from N. Line

250

Ft. from S. Line

250

Ft. from E. Line

Ft. from W. Line

ABANDONED

Location

Rig up

Drilling and Remarks:

Dry & Aband.

RECORD

Cased _____ in., _____ ft.

Sand _____

Gas _____

Oil _____

Total Depth 1990' #2H

PRODUCTION

1st 24 hrs. Nat. _____

1st 24 hrs. after shot _____

Gas _____ Cu. Ft.

Dry Hole ☒Abandoned ☒

Date

APR 24 1925192

W. L. Shewee
 Scout