

KANSAS


Lyon ✓

FORM 51 5M PETROL

Section 29 Township 21 Range 12E

Well No. 1 Houghton

Company Walker

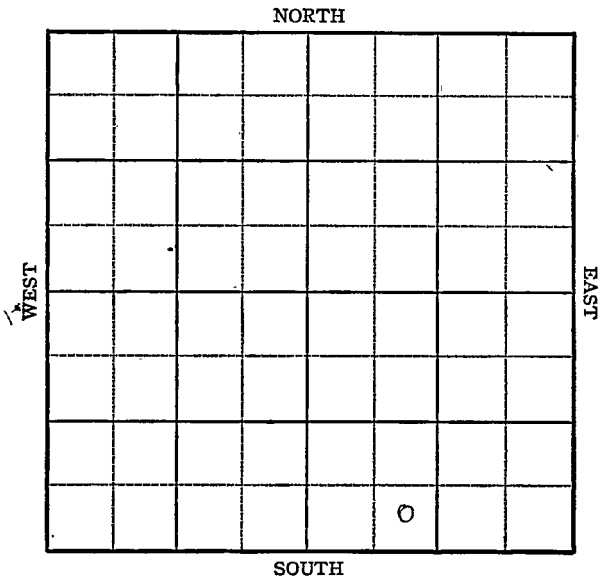

KANSAS Lyon

Sec. 29 Twp. 21 R. 12-E

Well No. #1 Houghton (TWIN) Farm

Walker Company


 Ft. from N. Line

330 Ft. from S. Line

 Ft. from E. Line

990 Ft. from W. Line

SE SW SE

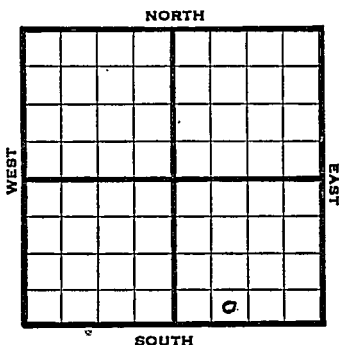

1945	REPORT		
9/5	Location		
9/26	"		
10/3	"		
10/10	"		
10/17	"		
10/24	"		
10/31	"		
11/7	"		
11/14	"		
11/21	"		
11/28	"		
12/5	"		
12/12	RURU		
12/20	"		
12/29	"		
1946			
1/10	10" - 14'	Bart 1884'	
	T.D. 1929'	7" - 1887'	
1/17	T.D. 1934'	Shot 40 qts. 1914-30'	C O
1/24	Shot 140 qts. 1915-33'		C.O.
1/31	Shot 40 qts. 1890-1903'		No help.
2/7	"	"	"
2/14	"	"	"
2/21	"	"	"
2/28	"	"	"
3/7	T.D. 1945'		
3/13	"	"	
3/21	C.O. 1946'		
3/28	T.D. 1956'	Shot 30 qts. 1938-56'	C.O.
OVER			

1946

4/4 TD 1956'
90 qts. 1938-1956 CO

4/10	"	"	"
4/16	"	"	"

4/23	"	"	"
------	---	---	---

5/1 Bart 1889
7" @ 1892
TD 1945
Pump 4 Pot.
Grav. 38.0

COMPLETED

KANSASKans Pool Name MiscellaneousMap No. 21 Sec. 29 Twp. 21 R. 12EWell No. 1 Houghton - Twin WellWalker

Company

COMPLETE

Contractor

SE SW SE

SECTION PLAT

 Ft. from N. Line330 Ft. from S. Line Ft. from E. Line990 Ft. from W. LineLyon CountyLocation Rig up

Drilling and Remarks:

*Bar 8/1888**7" C 1892**Pump 4/1888**38° 52'*

RECORD

Cased in., ft.Sand Gas Oil Total Depth 1945

PRODUCTION

1st 24 hrs. Nat. 1st 24 hrs. after shot Gas Cu. Ft.Dry Hole Abandoned

Date

MAY 1 1946

19

S. J. LEWIS

Scout

KANSAS

Pool Name MiscellaneousMap No. 21 Sec. 29 Twp. 21 R. 12EWell No. 1 HoughtonWalker

Company

FIRST REPORT

Contractor

SE SW SE

SECTION PLAT

 Ft. from N. Line330 Ft. from S. Line Ft. from E. Line990 Ft. from W. LineLyon CountyLocation XRig up

Drilling and Remarks:

RECORD

Cased in., ft.Sand Gas Oil Total Depth

PRODUCTION

1st 24 hrs. Nat. 1st 24 hrs. after shot Gas Cu. Ft.Dry Hole Abandoned

Date

SEP 5 1945 19S. J. LEWIS Scout

Return
to this a turn

Is this a Twin
well
advise
Sam

Just well

Misc. Small Maps	
Cards	<i>B. B. B.</i>
Tracing	<i>W. B.</i>
France Map	<i>[Signature]</i>
Scarborough Map	<i>[Signature]</i>
Pierce Map	<i>[Signature]</i>
Geological Dept.	
Pierce Plat Book	

KANSAS Name MiscellaneousMap No. _____ Sec. 29 Twp. 21 R. 12EWell No. 1 Houston twin well

Walker _____ Company

CORRECTION _____ Contractor

SE SW SE

SECTION PLAT

_____ Ft. from N. Line

330 Ft. from S. Line

_____ Ft. from E. Line

990 Ft. from W. Line

Lyons County

Location _____

Rig up _____

Drilling and Remarks:

RECORD

Cased _____ in., _____ ft.

Sand _____

Gas _____

Oil _____

Total Depth _____

PRODUCTION

1st 24 hrs. Nat. _____

1st 24 hrs. after shot _____

Gas _____ Cu. Ft.

Dry Hole _____

Abandoned _____

Date

SEP 26 1945

19

S. J. LEWIS

Scout