

Map No. **KANSAS** Sec. 29 Twp. 21^S R. 2^E

Well No. 1- General Farm
Mollenbaker, et al Company

NORTH

WEST

EAST

			0				

SOUTH

Location.....

Drilling Remarks

.....

.....

RECORD

Cased..... in..... ft.

Sand.....

Gas.....

Oil.....

Total Depth.....

Rig Up.....

Drilling Remarks

.....

.....

PRODUCTION

1st 24 hrs. Nat..... ft.

1st 24 hrs. after shot.....

Gas..... cu. ft.....

Dry Hole.....

Abandoned.....

Map No. Sec. Twp. R.

Well No. Farm


..... Company .

..... Ft. from N. Line

..... Ft. from S. Line

..... Ft. from E. Line

..... Ft. from W. Line

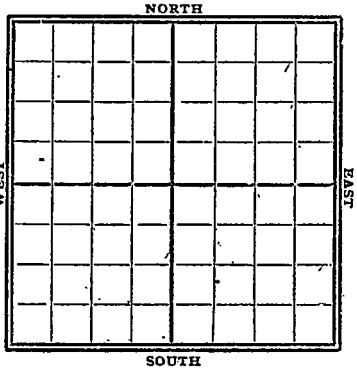

1920

Date

REPORT

Gypsum Records

4/16

Abd T.D. 2746'

MAP No. 48 K24 SEC. 29 TWP. 21S R. 2E

WELL No. 1 Commerce

Mallardick et al COMPANY

CONTRACTOR

SECTION PLAT

_____ FT. FROM N. LINE

_____ FT. FROM S. LINE

_____ FT. FROM E. LINE

_____ FT. FROM W. LINE

LOCATION _____

RIG UP _____

DRILLING AND REMARKS:

*OK well
over
run*

RECORD

CASED _____ IN. _____ FT.

SAND _____

GAS _____

OIL _____

TOTAL DEPTH 274 1/2

PRODUCTION

1ST 24 HRS. NAT. _____

1ST 24 HRS. AFTER SHOT _____

GAS _____ Cu. Ft.

DRY HOLE

ABANDONED

DATE

4/16 1920

SCOUT