


Map No. Kans Sec. 30 Twp. 21 R. 10
 Well No. 11-7 Atyes Farm
Transcontinental Company

NORTH

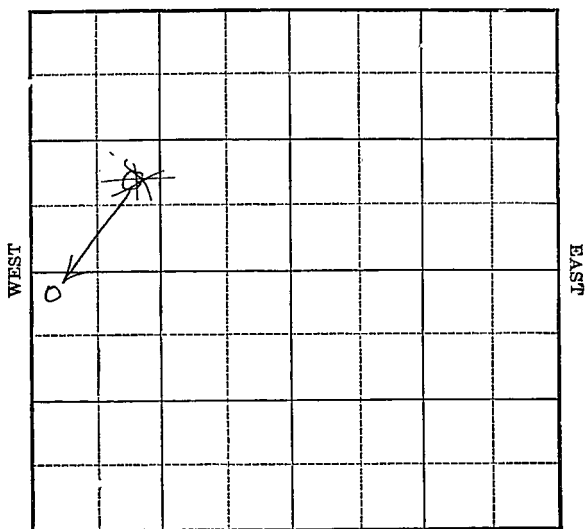

SOUTH

Location _____

Drilling Remarks _____

Rig Up _____

Drilling Remarks _____

RECORD

Cased _____ in. _____ ft.

Sand _____

Gas _____

Oil _____

Total Depth _____

PRODUCTION


1st 24 hrs. Nat. _____

1st 24 hrs. after shot _____

Gas _____ cu. ft.

Dry Hole _____

Abandoned _____

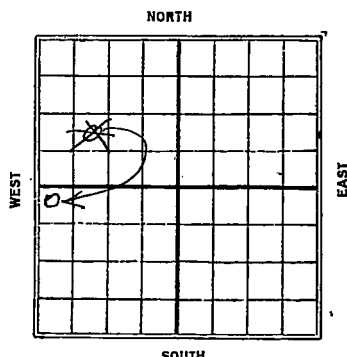Map No. 30 Lyon Sec. 21 Twp. 21 R. 10Well No. 11-A Atyco FarmTranscontinental Oil Company330 Ft. from N. Line990 Ft. from S. Line330 Ft. from E. Line990 Ft. from W. Line

1926

Date


REPORT

10/13 Rigging up
 10/27 drlg 11.05
 11/11 " 1300
 11/17 " 1985
 11/23 top sand 2229' Pay 2244-2283
 T.D. 2293-400' natural will
 shoot 140 gts.
 12/2 Sands 2229-2292
 Pay 2244-2283
 140/10 abbs
 T.D. 2292'

21 KANSAS 31 Twp. 21 R. 10
 Map No. Sec. Twp. R.

Well No. 11 # Ht 40 Farm
 Mon & Continental oil Company

NORTH

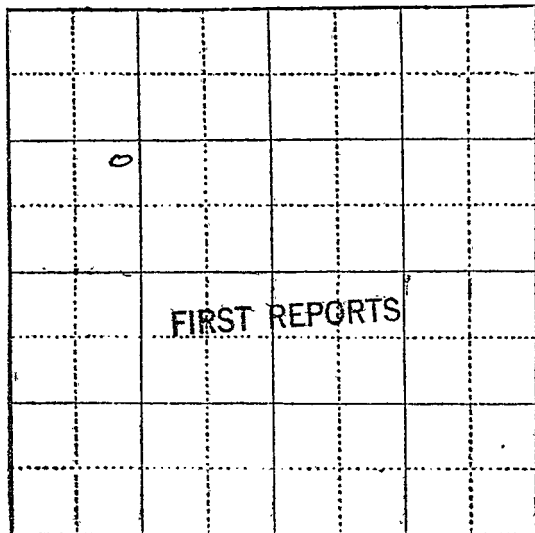

SOUTH

Location _____

Rig up _____

Drilling and Remarks:

RECORD

Cased _____ in., _____ ft.

Sand _____

Gas _____

Oil _____

Total Depth _____

PRODUCTION

1st 24 hrs. Nat. _____

1st 24 hrs. after shot _____

Gas _____ Cu. Ft.

Dry Hole _____

Abandoned _____

Date

OCT 13 1926

192

CHAS. L. SHERWOOD

Scout

Lyon

21 KANSAS
 Map No. _____ Sec. 30 Twp. 21 R. 10
 Well No. 11A 44460
 Transcontinental Oil Co Company

 Contractor

CORRECTION

330
 _____ Ft. from N. Line

_____ Ft. from S. Line

_____ Ft. from E. Line

330
 _____ Ft. from W. Line

SECTION PLAT

0			

Location _____

Rig up _____

Drilling and Remarks:

this well was previously
 reported in the 5000
 of Dec 31. Chy Sec
 number 2 location
 to above.

RECORD

Cased _____ in., _____ ft.

Sand _____

Gas _____

Total Depth _____

PRODUCTION

1st 24 hrs. Nat. _____

1st 24 hrs. after shot _____

Gas _____ Cu. Ft.

Dry Hole _____

Abandoned _____

Date

NOV 23 1926

CHAS. L. SHERWOOD

192

Scout

lyon
 21 KANSAS 30 21 10
 Map No. Sec. Twp. R.
 Well No. 11# #type
 2 Mon & Continental Oil Company

Contractor

COMPLETED

SECTION PLAT

330 Ft. from N. Line
 Ft. from S. Line
 Ft. from E. Line
 330 Ft. from W. Line

0			

Location

Rig up

Drilling and Remarks:

Pay 2244-83
 14ay/100 Bl.

RECORD

Cased in., ft.
 Sand 2229-2293
 Gas
 Oil
 Total Depth 2293

PRODUCTION

1st 24 hrs. Nat. _____
 1st 24 hrs. after shot _____
 Gas _____ Cu. Ft.
 Dry Hole _____
 Abandoned _____

Date

DEC 2 1926 CHAS. L. SHERWOOD
 192 Scout