


Section 30 Township 21 Range 10 E

Well No. # 1 Lowe

Company Stewart Oil

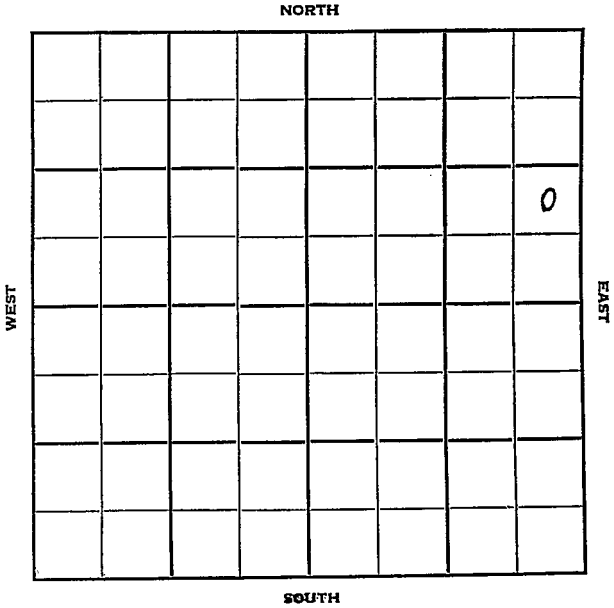

Sec. **30** Twp. **21** R. **10E**

Well No. **#1 Lowe** Farm

Stewart Oil Company

White & Ellis Contractor


Ft. from N. Line

990 Ft. from S. Line

330 Ft. from E. Line

Ft. from W. Line

NE SE NE

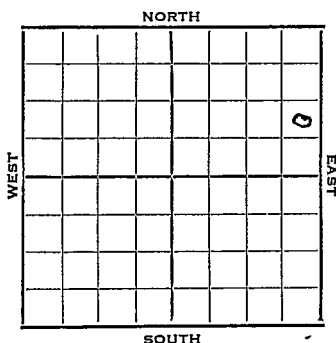

1952

R E P O R T

8/27

Spud 8-16-52

Lans. 1308'

KC 1501

B KC 1775

Miss 2358


TD 2365 NS D&A

**FIRST REPORT
+
ABANDONED**

County Lyon State Kansas
 Sec. 30 (Blk.) 21 (Sur.) 10E Map No.

Operator Stewart Oil
 Well No. 1 Farm Lowe

Elev. Location NE SE NE

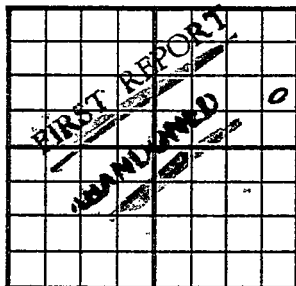

990 Ft. From S Line NE
330 Ft. From E Line Quarter

1st. Report AUG 27 1952

Completion AUG 27 1952

Remarks

White & Ellis - Contr.

Spudding Date 8-16-52

Drig. Data

Lans 1308 KC 1501 BKG 1775 Miss 2358
TD 2365 NS D&A

J. G. McGEHEE