


Section 30 Township 21S Range 12E

Well No. 1 Ray Harland

Company E. E. Sauder

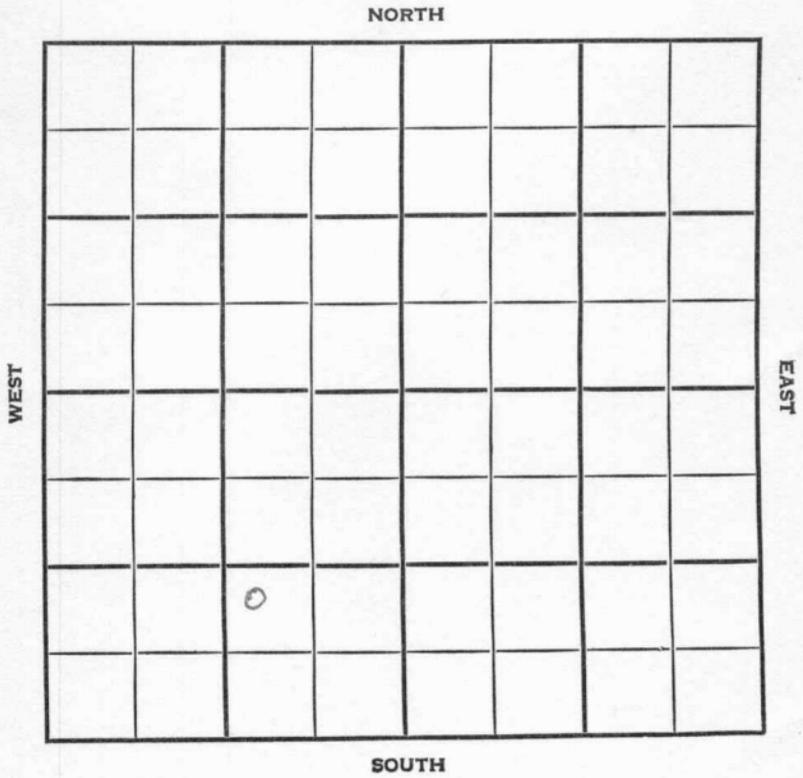

Lyon

KANSAS

SEC. 30	TWP. 21S	R. 12E
------------	-------------	-----------

WELL NO.

#1 Ray Harland

FARM

COMPANY

E. E. Sauder

CONTRACTOR

Sauder

Franchouser


_____ Ft. from N. Line

_____ Ft. from S. Line

_____ Ft. from E. Line

_____ Ft. from W. Line

NW SE SW

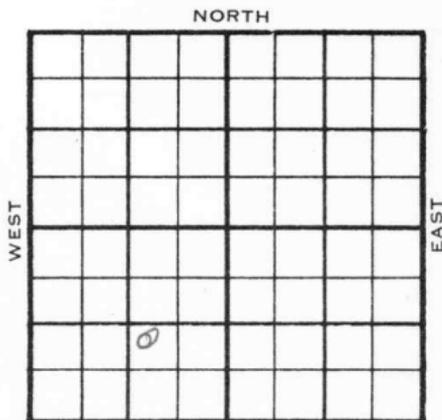

FIRST REPORT

1955	ELEVATION	REPORT
7/13	Spud 7-6-55 10" @ 898;	D900
7/27	Comm 7-6-55 Bartl 1828, M Chat 1945, M Li 1950 TD 1985 10" @ 898 D & A	8" @ 1378

ABANDONED

County Lyon Elev. _____
 Sec. 30 Twp. 21S Rge. 12E
 Company E. E. Sauder
 Farm Name Ray Harland No. 1

TOPS	DEPTH	LOG	DATUM
Anh.			
T.P.			
H.			
Tr.			
Dg.			
BL.			
L.			
K.C.			
B.K.C.			
Ce.			
C.			
M.			
M.			
K.			
Mz.			
Me.			
V.			
S.			
S.			
A.			
R.			
PE.			
G.			
T.D.			

Loc. in Sec. NW SE SW
 Geol. _____
 Contr. Sauder
 Pool Fanknouser

JUL 13 1955
 FIRST REPORT

Date Comm. spud 7-6-55; 10" 898; D 900

Co.
 Lse.
 No.
 Sec.
 T.
 R.

County Lyon Elev. _____
 Sec. 30 Twp. 21 Rge. 12E
 Company E. E. Sauder
 Farm Name Ray Harland No. 1

TOPS	DEPTH	LOG	DATUM
Anh.			
TP.			
H.			
Tr.			
D. <u>Bartl.</u>	<u>1828</u>		
BL.			
L.			
K.C.			
B.K.C.			
Ce.			
C.			
M.	<u>chat</u>	<u>1945</u>	
M.	<u>L1</u>	<u>1950</u>	
K.			
Mz.			
Mq.			
V.			
S.			
S.			
A.			
R.			
PE.			
G.			
T.D.	<u>1985</u>		

Loc. in Sec. _____
 NW SE SW
 Geol. _____
 Contr. _____
 Sauder
 Pool _____
 Frankhouser



Date Comm. 7-6-55 JUL 27 1955
 10" @ 1398' ... 8" @ 1378'

D & A

Co.
Lse.
No.
Sec.
T.
R.