

Section 30 Township 21 Range 11E

Well No. #1 Garriott

Company White & Ellis Drlg. Co.

NORTH

WEST	0							

EAST

SOUTH

Sec. 30 Twp. 21 R. 11E

Well No. #1 Garriott Farm

White & Ellis Drlg. Co. Company

White & Ellis Contractor


330 Ft. from N. Line

..... Ft. from S. Line

..... Ft. from E. Line

330 Ft. from W. Line

NW NW NW

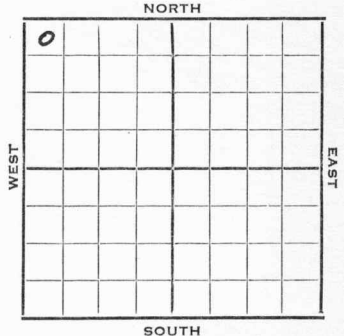

1953 Elev. - REPORT

7/8 Spud 6-30-53
 8" @ 102'
 Miss 2086
 Drlg 2134'

8/5 Spud 6-30-53
 D & A
 TD 2540'
 8" @ 102'
 Miss 2086, Viola 2540,
 TD 2540'
 5" @ 2536'
 CO to 2540'
 2 qt HFW
 D & A

ABANDONED

County Lyon State Kansas

Sec. 30 (Blk. 21) (Sur. 11E) Map No.

Operator White & Ellis

Well No. 1 Farm Garriott

Elev. _____ Location NW NW NW

0					

330 Ft. From N Line NW

330 Ft. From W Line Quarter

1st. Report

Completion AUG 5 1953

Remarks

White & Ellis - Contr.

Spudding Date 6-30-53

Drig. Data D & A TD 2540

8" @ 102 Miss. 2086 Viola 2540

TD 2540 5" @ 2536 CO to 2540

2 qt/ HEW

D & A

