


Section 30 Township 21S Range 12E

Well No. 3 Harold Smith

Company Geneva Oil & Gas

NORTH

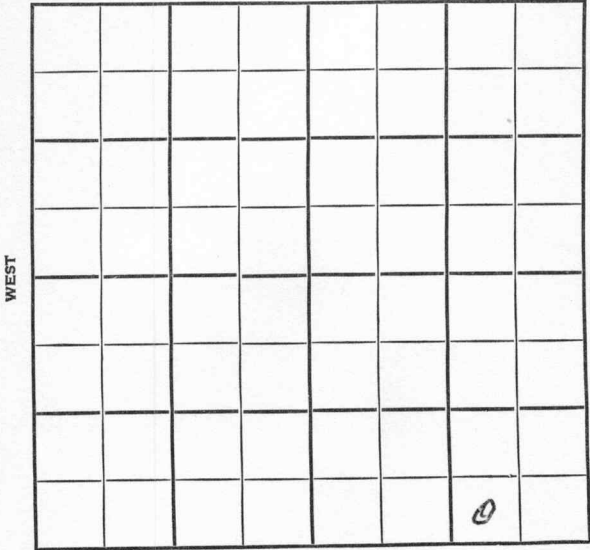

SOUTH

KANSAS

Lyon

SEC.	TWP.	R.
30	21 S	12 E

WELL NO. # 3 Harold Smith FARM

COMPANY Geneva Oil & Gas

CONTRACTOR


**Frankhouser**

\_\_\_\_\_ Ft. from N. Line

\_\_\_\_\_ Ft. from S. Line

\_\_\_\_\_ Ft. from E. Line

\_\_\_\_\_ Ft. from W. Line

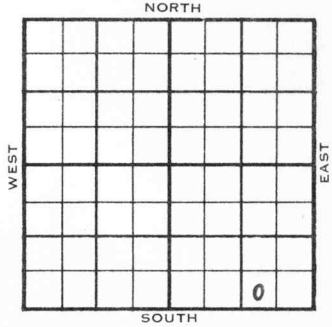

SW SE SE

ELEVATION

REPORT

1955

7/13

TD 1887' 5" @ 1877' CO 1887'  
 Frac. Pump 60 BO + 25 BWPD  
 Btv. sd 1875'  
 Btv. 1877-87'

FIRST REPORT  
 ↓  
 COMPLETED

