


KANSAS

Map No. _____ Sec. 30 Twp. 21 R. 10

Well No. 2 - Atigo Farm _____

Transcontinental Oil Company

NORTH

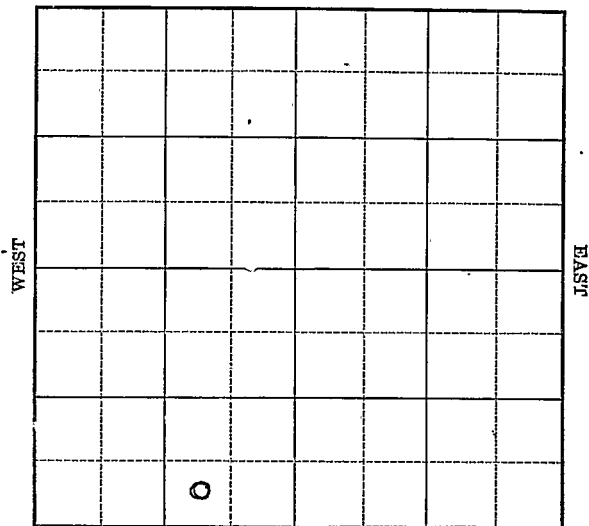

SOUTH

Location _____

Drilling Remarks _____

Rig Up _____

Drilling Remarks _____

RECORD

Cased _____ in. _____ ft.

Sand _____

Gas _____

Oil _____

Total Depth _____

PRODUCTION

1st 24 hrs. Nat. _____

1st 24 hrs. after shot _____

Gas _____ cu. ft.

Dry Hole _____

Abandoned _____

Lyons Co

Map No. _____ Sec. 30 Twp. 21 R. 10

Well No. 2 A types Farm


Transcontinental Company

_____ Ft. from N. Line

330' Ft. from S. Line

990' Ft. from E. Line

_____ Ft. from W. Line

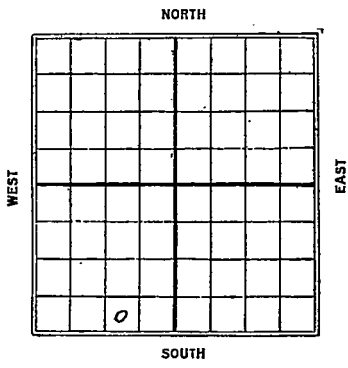

1926

REPORT

1/8	Rig	
1/4		
1/4		
1/20	300'	
1/27	Drly 824'	
2/4	Running 12" 1265'	
2/10	U. R. 10" 1350'	
2/17	Drly 1550'	
2/24	" 1640	
3/5	" 2140	
3/10	" 1775	
3/18	" 1810	
3/25	Pulling 10" 1810.	
4/1	Top sand 2145-2184' T.D. 2185 in shale 2100' oil in hole in 28 hours will shoot.	
4/7	—	
4/14	Sand 2145-2184 T.D. 2185 60 gts 375 bbls	

Lupon Co

Map No. *21* KANSAS Sec. *30* Twp. *21* R. *10*

Well No. *2* *HYEO*

Transcontinental oil Company

Contractor

FIRST REPORTS

SECTION PLAT

_____ Ft. from N. Line

330

_____ Ft. from S. Line

990

_____ Ft. from E. Line

_____ Ft. from W. Line

Location _____

Rig up

Drilling and Remarks:

RECORD

Cased _____ in., _____ ft.

Sand _____

Gas _____

Oil _____

Total Depth _____

PRODUCTION

1st 24 hrs. Nat. _____

1st 24 hrs. after shot _____

Gas _____ Cu. Ft.

Dry Hole _____

Abandoned _____

Date

JAN 8 1926

CHAS. L. SHERWOOD

192

Scout

K21 KANSAS Sec. 30 Twp. 21 R. 10

Well No. 2 types

Frank A Co Continental Oil Company

Contractor

COMPLETED

SECTION PLAT

Ft. from N. Line

330

Ft. from S. Line

990

Ft. from E. Line

Ft. from W. Line

	o		

Location

Rig up

Drilling and Remarks:

60/375 ss.

RECORD

Cased in., 8 ft.

Sand 2145-2184

Gas

Oil

Total Depth 2185

PRODUCTION

1st 24 hrs. Nat.

1st 24 hrs. after shot

Gas Cu. Ft.

Dry Hole

Abandoned

Date

APR 14 1926

CHAS. L. SHERWOOD

192 Scout