


Lyon

Map No. Kano Sec. 30 Twp. 21 R. 10Well No. 4-Atgeo FarmTrans Cont. Oil Company

NORTH

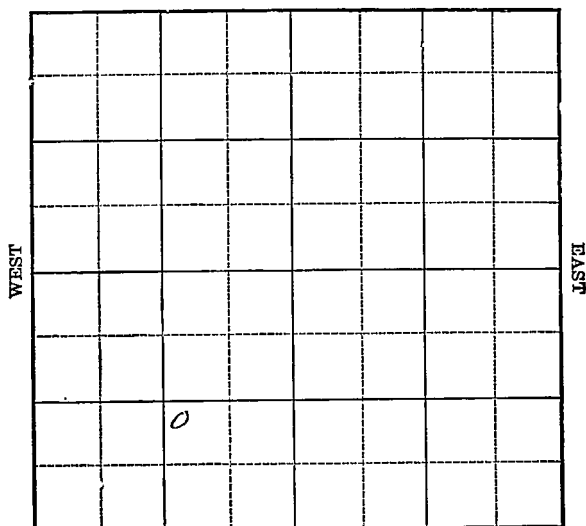

SOUTH

Location _____

Drilling Remarks _____

Rig Up _____

Drilling Remarks _____

RECORD

Cased _____ in. _____ ft.

Sand _____

Gas _____

Oil _____

Total Depth _____

PRODUCTION

1st 24 hrs. Nat. _____

1st 24 hrs. after shot _____

Gas _____ cu. ft.

Dry Hole _____

Abandoned _____


Lyon

Map No. Kansas Sec. 30 Twp. 21 R. 10Well No. 4 Attyes FarmTranscontinental Company

_____ Ft. from N. Line

990 Ft. from S. Line990 Ft. from E. Line

_____ Ft. from W. Line

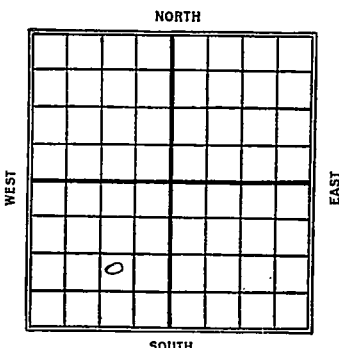

Date

REPORT

1926	
4/14	Location
4/21	Bldg Rig
4/28	Rign.
5/8	Log 385
5/14	" 935'
5/19	" 1250'
6/12	" 1755'
6/10	" 1980'
6/18	Top sand 2199 1st oil 2216 Drilling
6/24	Sand 2199-2271 10 gts 150 bbls

K21 KANSAS Sec. 30 Twp. 31 R. 10
 Map No. 4 Ulysses
 Well No. Transcontinental Oil Company

Contractor

FIRST REPORTS

SECTION PLAT

	0		

Ft. from N. Line

990 Ft. from S. Line

990 Ft. from E. Line

Ft. from W. Line

Location ✓

Rig up

Drilling and Remarks:

RECORD

Cased _____ in., _____ ft.

Sand _____

Gas _____

Oil _____

Total Depth _____

PRODUCTION

1st 24 hrs. Nat. _____

1st 24 hrs. after shot _____

Gas _____ Cu. Ft.

Dry Hole _____

Abandoned _____

Date

APR 14 1926

192

CHAS. L. SHERWOOD

Scout

hy 03
 1521 KANSAS 30 Twp. 21 R. 10
 Map No. Sec. Twp. R.

Well No. 4 type
 Transcontinental Company

Contractor

COMPLETED

SECTION PLAT

Ft. from N. Line

990 Ft. from S. Line

990 Ft. from E. Line

Ft. from W. Line

	0		

Location

Rig up

Drilling and Remarks:

107/150 lbs.

RECORD

Cased in., ft.

Sand 2199-2271'

Gas

Oil

Total Depth 2271'

PRODUCTION

1st 24 hrs. Nat.

1st 24 hrs. after shot

Gas Cu. Ft.

Dry Hole

Abandoned

Date

JUN 24 1926

192

CHAS. L. SHERWOOD

Scout