


KANSAS

Lyon

SECTION 30 TOWNSHIP 21 RANGE 12 E

WELL NO. #5 Nuessen

COMPANY Lotue Oil

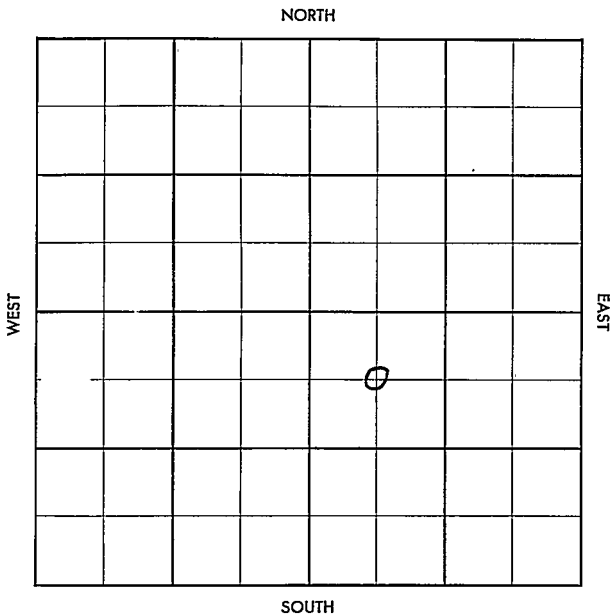

Lyon

KANSAS


SEC.	30	TWP.	21	R.	12E
------	----	------	----	----	-----

WELL NO. #5 Nuessen FARM

COMPANY Lotus Oil

CONTRACTOR Geneva Frankhouser

_____ Ft. from N. Line
 _____ Ft. from S. Line
 _____ Ft. from E. Line
 _____ Ft. from W. Line

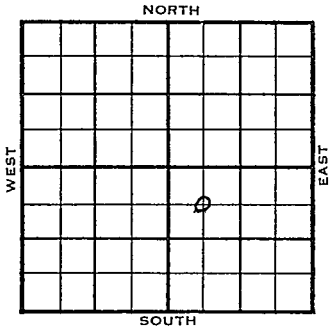

G NW SE

	ELEVATION	REPORT
1955		

11/9
 Comm 11-2-55
 8" @ 40
 Drlg 1050

No. 1000000

County Lyon Elev. 12E
 Sec. 30 Twp. 21 Rge. 12E
 Company Lotus Oil
 Farm Name Nuessen No. 5

TOPS	DEPTH	LOG	DATUM
Anh.			
Tp.			
H.			
Tr.			
Dg.			
Bl.			
L.			
K.C.			
B.K.C.			
Ce.			
C.			
M.			
M.			
K.			
Mz.			
Ma.			
V.			
S.			
S.			
A.			
R.			
Pe.			
G.			
TD.			

Loc. in Sec. C NW SE
 Geol. _____
 Contr. Geneva
 Pool Frankhouser

FIRST REPORT
 NOV 9 '55

Date Comm. 11-2-55
8" @ 40 d rlg. 1050

Co.

Lse.

No.

Sec.

T.

R.