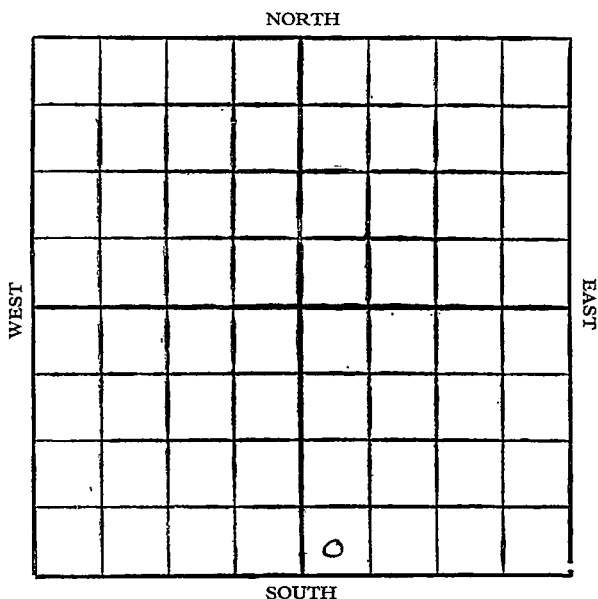


Map No. 15 Sec. 30 Twp. 21 R. 12 E ✓Well No. 1-Howard FarmLeonard et al Company

Location

Drilling Remarks

Rig Up

Drilling Remarks

RECORD

Cased in. ft.

Sand

Gas

Oil

Total Depth

PRODUCTION

1st 24 hrs. Nat.

1st 24 hrs. after shot

Gas cu. ft.

Dry Hole

Abandoned

Lyon

Map No. Kansas Sec. 30 Twp. 21 R. 12^EWell No. 1-Howard FarmLeonard et al Company

NORTH

_____ Ft. from N. Line

330 Ft. from S. Line

_____ Ft. from E. Line

330 Ft. from W. Line

WEST

EAST

SOUTH

Date

REPORT

19271/12 Location1/19 _____1/26 _____2/3 _____2/10 _____2/17 _____2/24 Rigging up3/2 _____3/9 Spudded + S.D.3/16 _____3/24 _____3/30 Spudding4/7 Spudding 12504/13 Casing trouble 9154/20 _____4/27 Drilg 12005/5 " 12455/12 S.D. 13055/25 Abandoned 1958


Lyon

21 KANSAS Map No. Sec. 30 Twp. 21 R. 12 NE

Well No. 1 Howard Farm

Leonard et al Company

NORTH

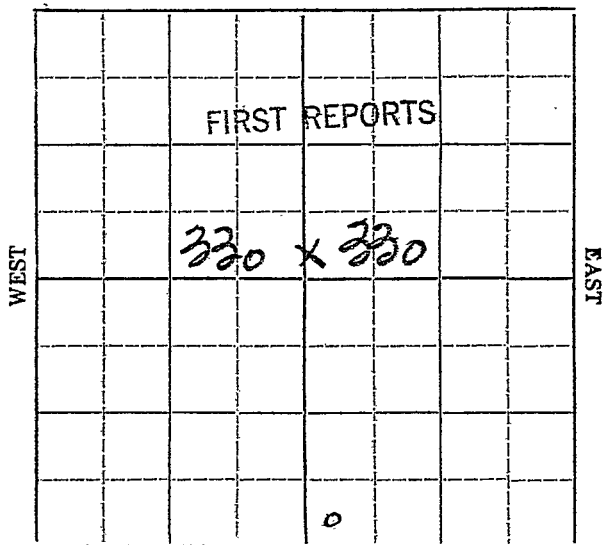

SOUTH

Location ✓

Rig up

Drilling and Remarks:

RECORD

Cased _____ in., _____ ft.

Sand _____

Gas _____

Oil _____

Total Depth _____

PRODUCTION

1st 24 hrs. Nat. _____

1st 24 hrs. after shot _____

Gas _____ Cu. Ft.

Dry Hole _____

Abandoned _____

Date JAN 12 1927

CHAS. L. SHERWOOD

192

Scout

Lyon

21 KANSAS Sec. 30 Twp. 21 R. 12

Map No. _____

Well No. 1 Howard

Leonard et al Company

Contractor

COMPLETED

SECTION PLAT

_____ Ft. from N. Line

330 _____ Ft. from S. Line

_____ Ft. from E. Line

330 _____ Ft. from W. Line

ABANDONED

Location _____

Rig up _____

Drilling and Remarks:

Sdy Shale 1806-40'

Sand 1852-85' med

" 1891-1900'

Tap line 1940'

1958'

RECORD

Cased _____ in., _____ ft.

Sand _____

Gas _____

Oil _____

Total Depth 1958'

PRODUCTION

1st 24 hrs. Nat. _____

1st 24 hrs. after shot _____

Gas _____ Cu. Ft.

Dry Hole. ✓

Abandoned. ✓

Date

MAY 25 1927

CHAS. L. SHERWOOD

192

Scout