


Section 30 Township 21 Range 12 E

Well No. #1 Nuessen

Company Lotus Oil

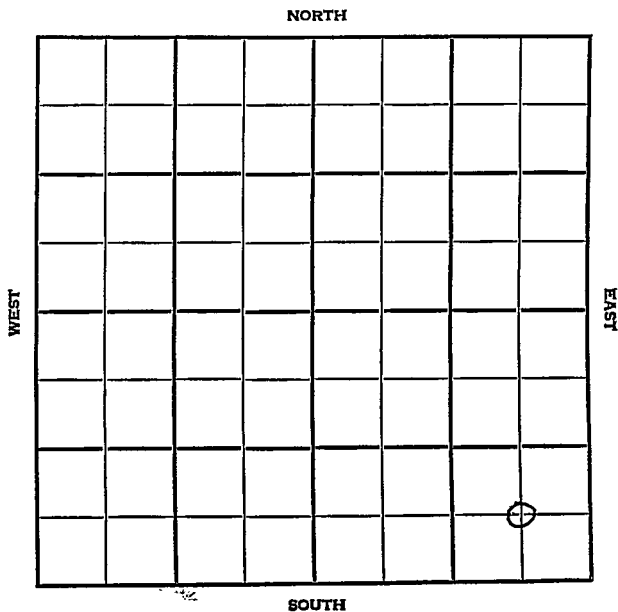

Lyon

KANSAS

SEC.	30	TWP.	21	R..	12E
------	----	------	----	-----	-----

WELL NO.

#4 Nuessen

FARM

COMPANY

Lotus Oil

CONTRACTOR

Geneva

Frankhouser


_____ Ft. from N. Line

_____ Ft. from S. Line

_____ Ft. from E. Line

_____ Ft. from W. Line

C SE/4

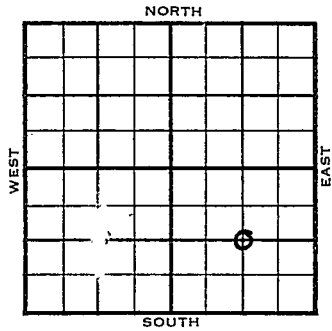

1955

ELEVATION

REPORT

10/5

Comm 9-28-55

8" @ 45

Bart

1901

TD 1903

4" @ 1903

10/19

Comm 9-28-55

8" @ 45

Bart 1901

TD 1951

TD 1903

4" @ 1903

DD 1951

PB 1947

Comp wtr input well

COMPLETED

Ma County

County Lyon Elev. _____
 Sec. 30 Twp. 21 Rgs. 12E
 Company Lotus Oil
 Farm Name Ivessen No. 4

TOPS	DEPTH	LOG	DATUM
Anh.			
TP.			
H.			
Tr.			
Dg.			
Bl.			
L.			
K.C.			
B.K.C.			
Ce.			
C. <u>Bart.</u>	<u>1901</u>		
M.			
K.			
Mz.			
Me.			
V.			
S.			
S.			
A.			
R.			
PE.			
G.			
TD.			

Loc. in Sec. G SE/4
 Geol. _____
 Contr. _____
Geneva
 Pool _____
Frankhouser



Date Comm. 9-28-55
8" @ 45 TD 1903 4" @ 1963

Co.
 Lse.
 No.
 Sec.
 T.
 R.

Madison County


County Lyon Elev. _____
 Sec. 30 Twp. 21 Rge. 12E
 Company Lotus Oil
 Farm Name Nuessen No. 4

TOPS	DEPTH	LOG	DATUM
Anh.			
Tp.			
H.			
Tr.			
Dg.			
Bl.			
L.			
K.C.			
B.K.C.			
Ce.			
C. <u>Bast</u>	<u>1901</u>		
M.			
M.			
K.			
Mz.			
Ma.			
V.			
S.			
S.			
A.			
R.			
PE.			
G.			
TD.	<u>1951</u>		

Loc. in Sec. G SE/4

Geol. _____
 Contr. Geneva

Pool Frankhouser

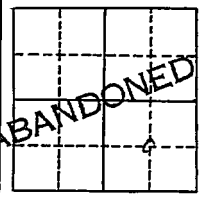

Date Comm. 9-28-55 OCT 19 1955

8" @ 45 TD 1903 4" @ 1903
DD 1951 PB 1947 Comp. water input well

Co.

Lse.

No.

Sec.

T.

R.