


Marion Co.

Map No. KANS Sec. 31 Twp. 21 R. 3
 Well No. 1 Osgood Farm
Hall et al Company

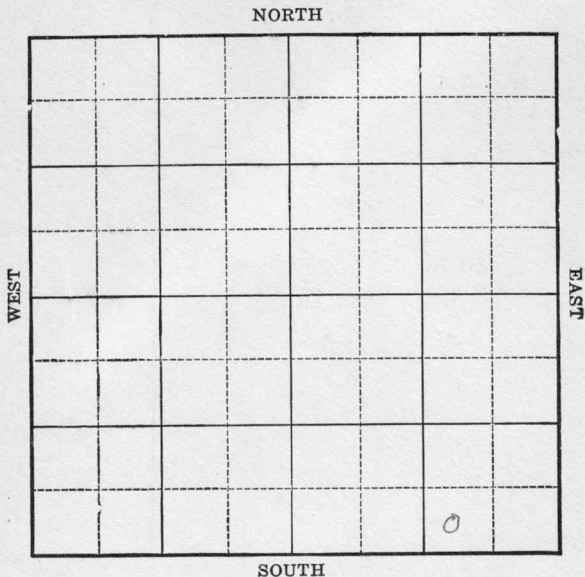

Location _____
 Drilling Remarks _____

Rig Up _____
 Drilling Remarks _____

RECORD

Cased _____ in. _____ ft.
 Sand _____
 Gas _____
 Oil _____
 Total Depth _____

PRODUCTION

1st 24 hrs. Nat. _____
 1st 24 hrs. after shot _____
 Gas _____ cu. ft.
 Dry Hole _____
 Abandoned _____


Marion Co

Map No. Kansas Sec. 31 Twp. 21 R. 5Well No. 1 Osgood FarmHall et al Company

Ft. from N. Line

330 Ft. from S. Line990 Ft. from E. Line

Ft. from W. Line

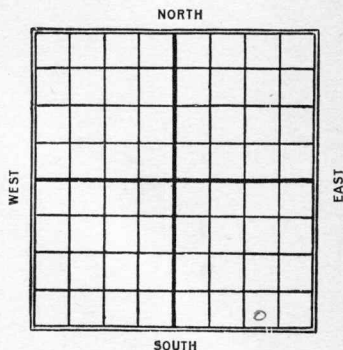

Date

REPORT

<u>1926</u>	
<u>6/30</u>	<u>Rig up</u>
<u>7/18</u>	<u>same</u>
<u>7/15</u>	<u>Spudded + S.D.</u>
<u>7/22</u>	<u>Dlg 500'</u>
<u>7/28</u>	<u>" 1000</u>
<u>8/4</u>	<u>Dlg 1350</u>
<u>8/11</u>	<u>running 6" 1675</u>
<u>8/18</u>	<u>Dlg 2110</u>
<u>8/25</u>	<u>log 6" 2270</u>
<u>8-31</u>	<u>—</u>
<u>9/16</u>	<u>—</u>
<u>9/22</u>	<u>Dry 2406</u>
<u>9/29</u>	<u>Abandoned 2448 HFW</u>
	<u>I.D. 2448</u>

K23 **KANSAS** *31* *21* *5*
 Map No. _____ Sec. _____ Twp. _____ R. _____

Well No. *1 05 gas*
Hahh et Ah _____ Company _____

Contractor _____

FIRST REPORTS

_____ Ft. from N. Line

320 _____ Ft. from S. Line

990 _____ Ft. from E. Line

_____ Ft. from W. Line

SECTION PLAT

			o

Location _____

Rig up ☒ _____

Drilling and Remarks:

RECORD

Cased _____ in., _____ ft.

Sand _____

Gas _____

Oil _____

Total Depth _____

PRODUCTION

1st 24 hrs. Nat. _____

1st 24 hrs. after shot _____

Gas _____ Cu. Ft.

Dry Hole _____

Abandoned _____

Date

JUN 30 1926

192

CHAS. L. SHERWOOD

Scout

23 KANSAS 3, Marion Co 5
 Map No. _____ Sec. _____ Twp. _____ R. _____

Well No. 1 *Adgood*
Half et al _____ Company

_____ Contractor

COMPLETED

SECTION PLAT

_____ Ft. from N. Line

330 _____ Ft. from S. Line

990 _____ Ft. from E. Line

_____ Ft. from W. Line

ABANDONED

			o

Location _____

Rig up _____

Drilling and Remarks:

DQ g

2448' HFH.

RECORD

Cased _____ in., _____ ft.

Sand _____

Gas _____

Oil _____

Total Depth *2448'*

PRODUCTION

1st 24 hrs. Nat. _____

1st 24 hrs. after shot _____

Gas _____ Cu. Ft.

Dry Hole *✓* _____

Abandoned *✓* _____

Date

SEP 20 1926

CHAS. L. SHEPHERD

192

Scout