


Marion KANSAS

SECTION 31 TOWNSHIP 21S RANGE 3E

WELL NO. #1 Davis

COMPANY J.S. Sutton

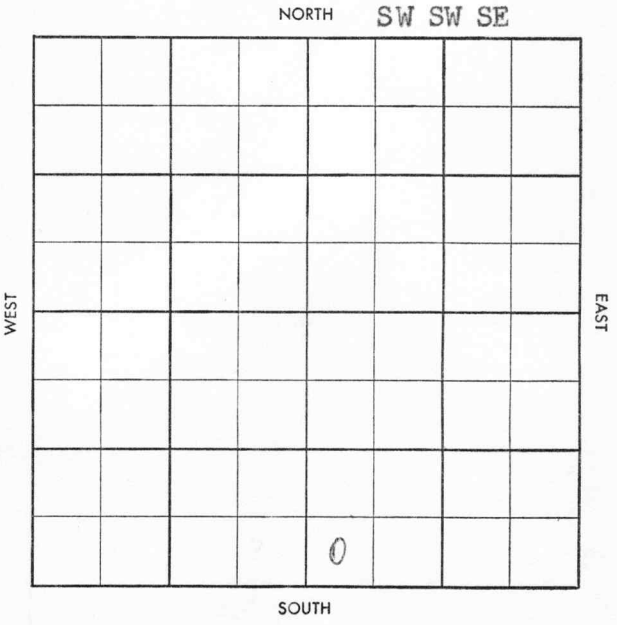

Twp. Pool
 Co. Facet

S-513-B

County Marion Elev. _____
 Sec. 31 Twp. 21 Rge. 3E
 Company J. S. Sutton
 Farm Name Davis No. 1

TOPS	DEPTH	LOG	DATUM
Anh.			
Tp.			
H.			
Tr.			
Dg.			
B.L.			
L.			
K.C.			
B.K.C.			
Ce.			
C.			
M.			
M.			
K.			
Mz.			
Mq.			
V.			
S.			
S.			
A.			
R.			
Pf.			
G.			
T.D.			

Loc. in Sec. SW SW SE
 Geol. _____
 Contr. _____
Co. tools
 Pool Doyle Creek



Date Comm. _____
Location

Co.
Lse.
No.
Sec.
T.
R.

Twp. ~~Perkins~~


Co. ~~Franklin~~

5-513.B

County Marion Elev 1430 DF 1433 RB
 Sec. 31 Twp. 21 Rge. 3E
 Company J. S. Sutton
 Farm Name Davis No. 1

TOPS	DEPTH	LOG	DATUM
Anh.			
Tp.			
H.			
Tr.			
Dg.			
B.L.			
L.	2032		
K.C.			
B.K.C.			
Ce.			
C.	2610		
M.			
M.	2758		
K.	2879		
Mz. <u>Hunt</u>			
Mq.			
V.			
S.			
S.			
A.			
R.			
Pf.			
G.			
T.D.	2882		

Loc. in Sec. SW SW SE
 Geol. _____
 Contr. Co. tools
 Pool _____
Doyle Creek

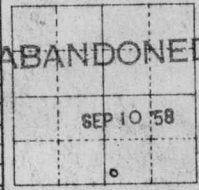

Date Comm. 7-18-58 8'180
 Location JUL 23 '58 Ø1770 JUL 30 '58

5" 2881 woc AUG 6 '58 DDAT 2904
AUG 13 '58 AUG 20 '58 SD AUG 27 '58 SEP 3 '58 SEP 10 '58

20 2482 tst 50 100 A wouldn't take
150 A tst 39 w ph DP 2904 NS

T6A