

Marion


KANSAS

SECTION 31 TOWNSHIP 21 RANGE 3 E

WELL NO. #1 Kent

COMPANY Anderson-Prichard

NORTH

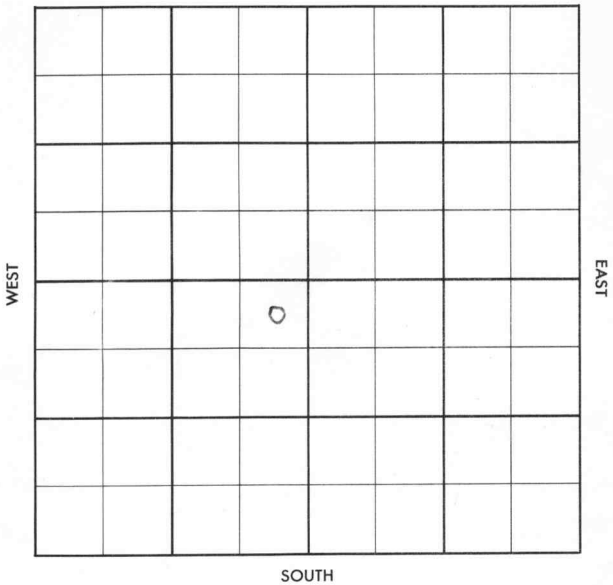

Marion

KANSAS

|      |      |    |
|------|------|----|
| SEC. | TWP. | R. |
| 31   | 21   | 3E |

WELL NO.

#1 Kent

FARM

COMPANY

Anderson Prichard

CONTRACTOR

Glenn Peel

Wildcat


\_\_\_\_\_ Ft. from N. Line

\_\_\_\_\_ Ft. from S. Line

\_\_\_\_\_ Ft. from E. Line

\_\_\_\_\_ Ft. from W. Line

NE NE SW

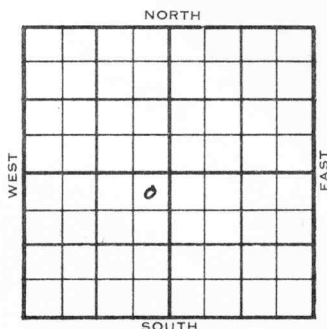

1955

ELEVATION

1444'

REPORT

11/2

Loc

11-23

Comm. 11-6-55

8 5/8" @ 105/25

DST 2868-2909 op 1 hr. rec. 40' ocm,  
980/20"DST 2867-2914 op 1 hr. rec. 1860' soc  
sul. wtr., 1050/20"

D &amp; A

TopsDepthLog

L.

2044

2044

M.

2648

2644

K.

2800

Mz.

2904

Hunt

2906

2904

V.

2990

2988

S.

3037

3037

A

3104

TD 3140'

ABANDONED

County

Marion

Elev.

Sec.

37

Twp.

21

Ree.

3E

**Company**

Anderson-Prichard

Farm Name

Kent

No.

7

| TOPS   | DEPTH | LOG | DATUM | Loc. in Sec. |
|--------|-------|-----|-------|--------------|
| Anh.   |       |     |       | NE NE SW     |
| TP.    |       |     |       |              |
| H.     |       |     |       |              |
| Tr.    |       |     |       |              |
| Dg.    |       |     |       |              |
| BL.    |       |     |       |              |
| L.     |       |     |       | Geol.        |
| K.C.   |       |     |       | Contr.       |
| B.K.C. |       |     |       | Glenn Peel   |
| Ce.    |       |     |       | Pool         |
| C.     |       |     |       | Wildcat      |
| M.     |       |     |       |              |
| M.     |       |     |       |              |
| K.     |       |     |       |              |
| Mz.    |       |     |       |              |
| Mq.    |       |     |       |              |
| V.     |       |     |       |              |
| S.     |       |     |       |              |
| S.     |       |     |       |              |
| A.     |       |     |       |              |
| R.     |       |     |       |              |
| Pe.    |       |     |       |              |
| G.     |       |     |       |              |
| TP.    |       |     |       |              |

Date Comm.

Location

Co.

Use

No.

Sec.

1

ス

County Maxion Elev. 1444Sec. 31 Twp. 21 Rge. 3ECompany Anderson-PrichardFarm Name Kent No. 1

TOPS

DEPTH

LOG

DATUM

Loc. in Sec.

Anh.

Tp.

H.

Tr.

Dg.

BL.

L.

K.C.

B.K.C.

Ce.

C.

M.

M.

K.

Mz.

Mo.

V.

S.

S.

A.

R.

PE.

G.

T.D.

2044 2044 600

Geol.

Contr.

Glenn Peel

Pool

Wildcat2800 13562904 14602906 2904 14602980 2988 15443037 3037 15933104 1660

ABANDONED

Date Comm. 11-6-55

NOV 23 1955

8 5/8" @ 105/25 DST 2868-2909open 1 hr. rec. 40' ocm 980/20"DST 2867-2914 open 1 hr. rec. 1860'soc sul. wtr. 1050/20"

D &amp; A