


Lyons

Map No. *MAN* Sec. *31* Twp. *21* R. *10*

Well No. *7A* *Atyes* Farm

Trans - cont al Company

NORTH

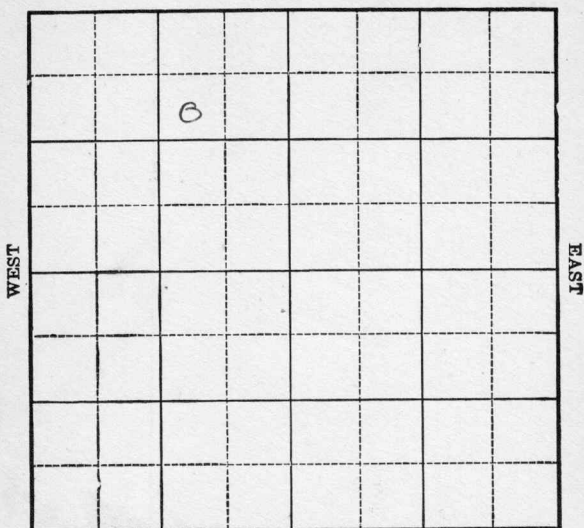

SOUTH

Location _____

Drilling Remarks

Rig Up _____

Drilling Remarks

RECORD

Cased _____ in. _____ ft.

Sand _____

Gas _____

Oil _____

Total Depth _____

PRODUCTION

1st 24 hrs. Nat. _____

1st 24 hrs. after shot _____

Gas _____ cu. ft.

Dry Hole _____

Abandoned _____


Lyons

Map No. 174N Sec. 31 Twp. 21 R. 10Well No. 7-A Atyco Farm
Transcontinental Company990 Ft. from N. Line

_____ Ft. from S. Line

975 Ft. from E. Line

_____ Ft. from W. Line

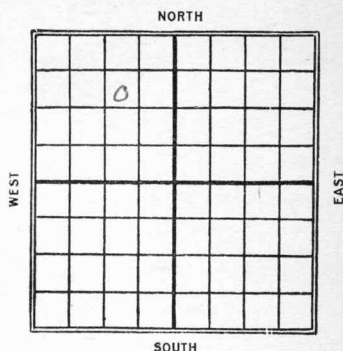1926

Date

REPORT

9/1 S.D. 645
9/16 Drilg 1210
9/22 " 2045
9/29 Sand 2140-2210
 Pay 2163-2210
 140/100 bbls
 I.D. 2219

2 KANSAS

Map No. _____ Sec. 31 Twp. 21 R. 10

Well No. 7# H type

Han Continental Co. Company

Contractor

FIRST REPORTS

SECTION PLAT

990 Ft. from N. Line

Ft. from S. Line

975 Ft. from E. Line

Ft. from W. Line

	0		

Location 15 feet

Rig up

Drilling and Remarks:

S/O 645'

RECORD

Cased _____ in., _____ ft.

Sand _____

Gas _____

Oil _____

Total Depth _____

PRODUCTION

1st 24 hrs. Nat. _____

1st 24 hrs. after shot _____

Gas _____ Cu. Ft.

Dry Hole _____

Abandoned _____

Date

SEP 1 1926

CHAS. L. SHERWOOD

192

Scout

KANSAS

Well No. _____
Map No. _____ Sec. _____ Twp. _____ R. _____

Company _____
Contractor _____

FIRST REPORTS

SECTION PLAT

_____ Ft. from N. Line
 _____ Ft. from S. Line
 _____ Ft. from E. Line
 _____ Ft. from W. Line

RECORD

Gas _____ ft.
 Sand _____
 Gas _____
 Oil _____
 Total Depth _____

PRODUCTION

at 24 hrs. Nat. _____
 at 24 hrs. after shot _____
 Gas _____
 Oil _____
 Water _____
 Sand _____

Location _____
 Rig up _____
 Drilling and Remarks: _____

Returned

Cards

Indexing

Map

Scarborough Map

Moody Map

Scarborough Plat Book

Moody Plat Book

SHERWOOD

21 KANSAS 31 21 10
 Map No. Sec. Twp. R.
 Well No. 7 H types
 Transcontinental Oil Company

Contractor

COMPLETED

SECTION PLAT

990 Ft. from N. Line

Ft. from S. Line

975 Ft. from E. Line

Ft. from W. Line

	0		

Location

Rig up

Drilling and Remarks:

Pay 2163-2210

14a 100 fl.

RECORD

Cased in. ft.

Sand 2140-2210

Gas

Oil

Total Depth 2219'

PRODUCTION

1st 24 hrs. Nat.

1st 24 hrs. after shot

Gas Cu. Ft.

Dry Hole

Abandoned

Date

SEP 29 1926

192

CHAS. I. SHERWOOD

Scout

abandoned 2219 feet
 on August 11th on
 account of freshening
 job shore later &
 made 100 bbl
 well.

RECORD
 Cased in
 Sand
 Gas
 Oil
 Total Depth

PRODUCTION
 24 hrs. Nat.
 24 hrs. after shot

Returned	
Cards	<i>[Signature]</i>
Tracing	<i>[Signature]</i>
France Map	
Scarborough Map	<i>[Signature]</i>
Moody Map	
Scarborough Plat Book	
Moody Plat Book	