


Map No. Kansas Sec. 31 Twp. 21 R. 10Well No. 10 Styco FarmShedy ita Company

NORTH

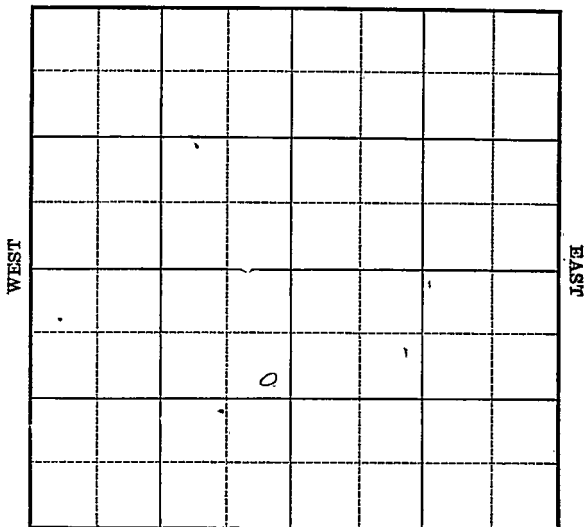

SOUTH

Location _____

Drilling Remarks _____

Rig Up _____

Drilling Remarks _____

RECORD

Cased _____ in. _____ ft.

Sand _____

Gas _____

Oil _____

Total Depth _____

PRODUCTION

1st 24 hrs. Nat. _____

1st 24 hrs. after shot _____

Gas _____ cu. ft.

Dry Hole _____


Abandoned _____

Map No. Kansas Sec. 31 Twp. 21 R. 10Well No. 10 Atyo FarmShedy et al Company990 Ft. from N. Line

Ft. from S. Line

330 Ft. from E. Line

Ft. from W. Line

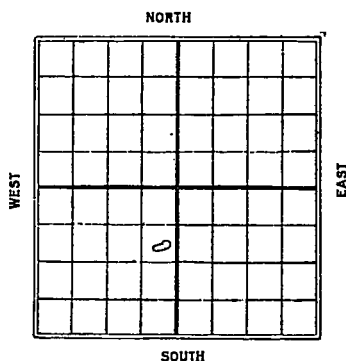Date
1926

REPORT

5/26 Bldg Rig6/2 Rig6/10 Rigging up6/184-25 Dlg 450'6-20 1175'7/8 11 19507/14 ld. 2273-2310 - T.D. 2310

K-21 KANSAS 31 Twp. 21 R. 10
 Map No. Sec. Twp. R.

Well No. 10
 Shedy et al Company

Contractor

FIRST REPORTS

990 Ft. from N. Line

Ft. from S. Line

330 Ft. from E. Line

Ft. from W. Line

SECTION PLAT

Location

Rig up

Drilling and Remarks:

Flow rig

RECORD

Cased _____ in., _____ ft.

Sand _____

Gas _____

Oil _____

Total Depth _____

PRODUCTION

1st 24 hrs. Nat. _____

1st 24 hrs. after shot _____

Gas _____ Cu. Ft.

Dry Hole _____

Abandoned _____

Date

MAY 26 1926

CHAS. L. SHERWOOD

192

Scout

K21 **KANSAS** *hyon*
 Map No. *31* Sec. *21* Twp. *21* R. *10*

Well No. *10* *type*
Sheddy *et al* Company

Contractor

COMPLETED

SECTION PLAT

990 Ft. from N. Line

Ft. from S. Line

330 Ft. from E. Line

Ft. from W. Line

Location

Rig up

Drilling and Remarks:

RECORD

Cased in. ft.

Sand *2273-2310*

Gas

Oil

Total Depth *2310*

PRODUCTION

1st 24 hrs. Nat.

1st 24 hrs. after shot

Gas Cu. Ft.

Dry Hole

Abandoned

Date

1607 250 *SS.*
 JUL 14 1926

CHAS. L. SHERWOOD

192

Scout