


Map No. Kans. Sec. 31 Twp. 21 R. 10
 Well No. 1- "a" atges Farm _____
Trans. Cont. Oil Company _____

NORTH

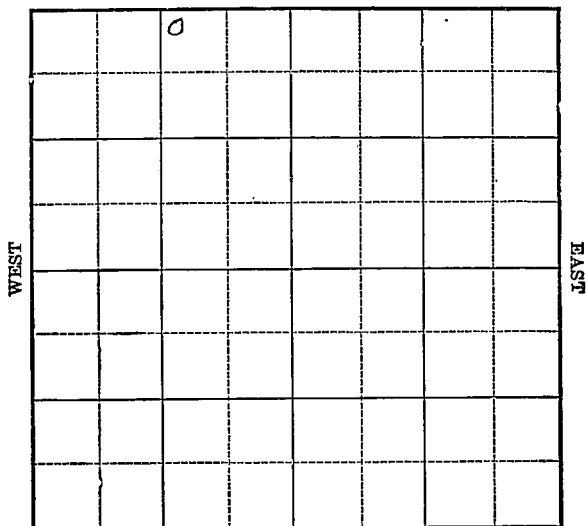

SOUTH

Location _____
 Drilling Remarks _____

Rig Up _____
 Drilling Remarks _____

RECORD

Cased _____ in. _____ ft.
 Sand _____
 Gas _____
 Oil _____
 Total Depth _____

PRODUCTION

1st 24 hrs. Nat. _____
 1st 24 hrs. after shot _____
 Gas _____ cu. ft.
 Dry Hole _____
 Abandoned _____

hyons
 Map No. **KANSAS** Sec. *31* Twp. *21* R. *10*
 Well No. *1 H etypeo*
Transcontinental Oil Company

Contractor

FIRST REPORTS

SECTION PLAT

330 Ft. from N. Line

_____ Ft. from S. Line

990 Ft. from E. Line

_____ Ft. from W. Line

	o		

Location _____

Rig up *Timbers.*

Drilling and Remarks:

RECORD

Cased _____ in., _____ ft.

Sand _____

Gas _____

Oil _____

Total Depth _____

PRODUCTION

1st 24 hrs. Nat. _____

1st 24 hrs. after shot _____

Gas _____ Cu. Ft.

Dry Hole _____

Abandoned _____

Date

APR 14 1926

192

CHAS. L. SHERWOOD

Scout

K21 KANSAS 31 Twp. 21 R. 10
 Map No. Sec. Twp. R.

Well No. 14 styco
 Transcontinental Co. Company

Contractor

COMPLETED

330 Ft. from N. Line

Ft. from S. Line

990 Ft. from E. Line

Ft. from W. Line

SECTION PLAT

	0		

Location

Rig up

Drilling and Remarks:

ba / 200 fl.

RECORD

Cased in. ft.

Sand 2134-2166

Gas

Oil

Total Depth 2166

PRODUCTION

1st 24 hrs. Nat.

1st 24 hrs. after shot

Gas Cu. Ft.

Dry Hole

Abandoned

Date

JUN 2 1926

CHAS. L. SHERWOOD

Scout