


Map No. 1 Sec. 31 Twp. 21 R. 10Well No. 7A Atyeo FarmTranscontinental Company

NORTH

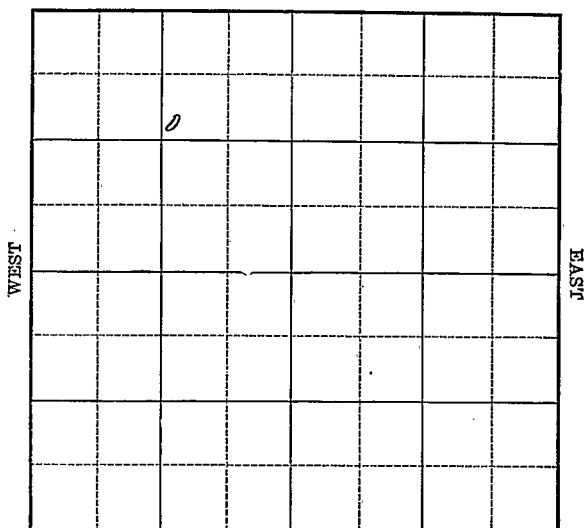

SOUTH

Location _____

Drilling Remarks _____

Rig Up _____

Drilling Remarks _____

RECORD

Cased _____ in. _____ ft.

Sand _____

Gas _____

Oil _____

Total Depth _____

PRODUCTION

1st 24 hrs. Nat. _____

1st 24 hrs. after shot _____

Gas _____ cu. ft.

Dry Hole _____

Abandoned _____

Lyon

Map No. Kansas Sec. 31 Typ. 21 R 10Well No. 7^H Atyeo FarmTranscontinental Company

NORTH

990 Ft. from N. Line


Ft. from S. Line

990 Ft. from E. Line

Ft. from W. Line

WEST

EAST

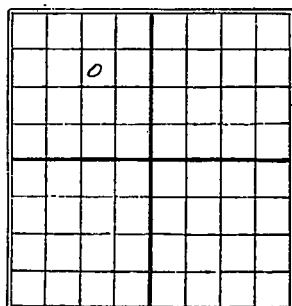

SOUTH

Date	REPORT
1926	
6/2	Location
6/10	Bldg rig
6/18	Rig
6/25	
6-30	Rigging up
7/8	Dlg 610'
7/15	" 1280
7/22	" 1850
7/28	sand 2141-5-6' shale 56-63
	sand & pay 2163-2210'
	broken sand 2210-2219
	T.D. shot 80 gta, shot
	pipe up, fishing
8/11	Sand 2141-2210
	80/shot co up
	abnd account bad
	fishing job.
	T.D. 2219

K21 KANSAS Sec. 31 Twp. 21 R. 10

Well No. 74 ktyeo
 Transcontinental oil Company

Contractor

FIRST REPORTS

SECTION PLAT

990 Ft. from N. Line

_____ Ft. from S. Line

990 Ft. from E. Line

_____ Ft. from W. Line

	o		

Location ✓ _____

Rig up _____

Drilling and Remarks:

RECORD

Cased _____ in., _____ ft.

Sand _____

Gas _____

Oil _____

Total Depth _____

PRODUCTION

1st 24 hrs. Nat. _____

1st 24 hrs. after shot _____

Gas _____ Cu. Ft.

Dry Hole _____

Abandoned _____

Date

1926

JUN 2

CHAS. L. SHERWOOD

192

Scout

21 *Lyon*
 Map No. KANSAS Sec. 21 Twp. 21 R. 10

Well No. 7 # *Hyles*
Land Continental Oil Co. Company

Contractor

COMPLETED

SECTION PLAT

990 Ft. from N. Line

_____ Ft. from S. Line

990 Ft. from E. Line

_____ Ft. from W. Line

ABANDONED

	0		

Location _____

Rig up _____

Drilling and Remarks:

gas shot csg up
1st 24 hrs. Nat.
1st 24 hrs. after shot
gas
dry hole

RECORD

Cased _____ in., _____ ft.

Sand 2141- 2210

Gas _____

Oil _____

Total Depth 2219

PRODUCTION

1st 24 hrs. Nat. _____

1st 24 hrs. after shot _____

Gas _____ Cu. Ft.

Dry Hole _____

Abandoned ☒

Date

AUG 11 1926

CHAS. L. SHERWOOD

192

Scout