


Lyon

Map No. *15* Sec. *31* Twp. *21* R. *10*

Well No. *9A* *Atyes* Farm

Transcontinental Company

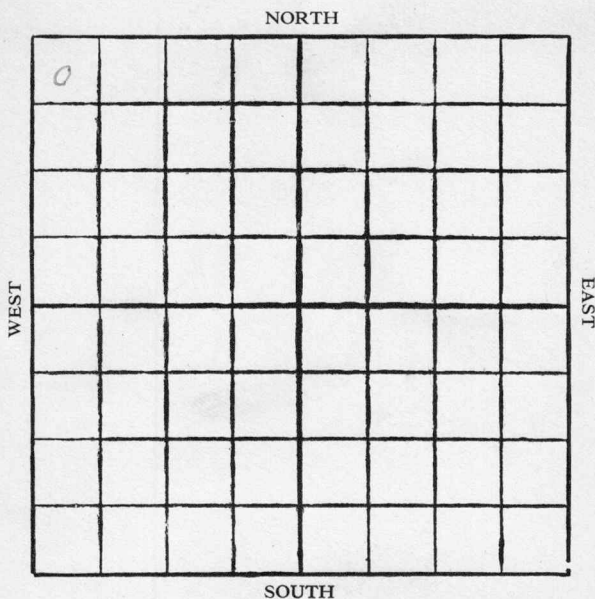

Location

Drilling Remarks

.....

.....

RECORD

Cased in. ft.

Sand

Gas

Oil

Total Depth

Rig Up.....

Drilling Remarks

.....

.....

PRODUCTION

1st 24 hrs. Nat.

1st 24 hrs. after shot

Gas cu. ft.

Dry Hole

Abandoned

Lyon


Map No. Ks Sec. 31 Twp. 21 R. 10Well No. 9-A Attyco Farm
Transcontinental Company330 Ft. from N. Line

Ft. from S. Line

Ft. from E. Line

330 Ft. from W. Line1926

NORTH

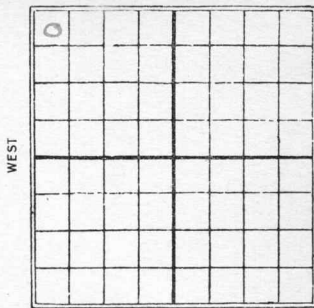

SOUTH

Date

REPORT

12/22 Rigging up
12/30 Spudding

1927

1/6 Drlg 495

1/13 " 1050

1/19 " 1535

1/26 " 1840

2/3 Top sand 2169-2202 show oil
2182 - broken sand 2202-08
T.D. 2219 in shale, filled
up 100' in 10 hrs. - 140 qt.
shot in hole -

2/10 sand 2169-2202
Bknsd 2202-08
shale 2208-2219
140/35 bbls

21 KANSAS 31 Twp. 21 R. 10
 Map No. Sec. Twp. R.
 Well No. 9^H Htyeo
 Transcontinental Oil Company

Contractor

FIRST REPORTS

SECTION PLAT

°			

330 Ft. from N. Line

Ft. from S. Line

Ft. from E. Line

330 Ft. from W. Line

Location

Rig up

Drilling and Remarks:

Rigging up

RECORD

Cased in, ft.

Sand

Gas

Oil

Total Depth

PRODUCTION

1st 24 hrs. Nat.

1st 24 hrs. after shot

Gas Cu. Ft.

Dry Hole

Abandoned

Date

DEC 22 1926

192

CHAS. L. SHERWOOD

Scout

21 KANSAS 31 Twp. 21 R. 10
 Map No. Sec. Twp. R.
 Well No. 9# Htyuo
 transcontinental oil Company

Contractor

COMPLETED

SECTION PLAT

330 Ft. from N. Line

Ft. from S. Line

Ft. from E. Line

330 Ft. from W. Line

0			

Location

Rig up

Drilling and Remarks:

sand 2169-2202
 broken sand 2202-08
 shale 2208-2219

144/35 BS

RECORD

Cased _____ in., _____ ft.

Sand _____

Gas _____

Oil _____

Total Depth 2219

PRODUCTION

1st 24 hrs. Nat. _____

1st 24 hrs. after shot _____

Gas _____ Cu. Ft.

Dry Hole _____

Abandoned _____

Date

FEB 10 1927

CHAS. L. SHERWOOD

192

Scout