


Map No. Sec. 31 Twp. 21 R. 10

Well No. 57 Atyes Farm

Transcontinental Company

NORTH

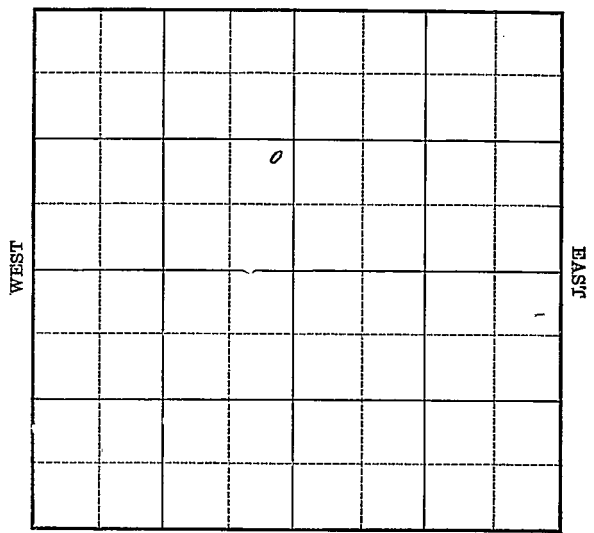

SOUTH

Location _____

Drilling Remarks _____

RECORD

Cased _____ in. _____ ft.

Sand _____

Gas _____

Oil _____

Total Depth _____

Rig Up _____

Drilling Remarks _____

PRODUCTION

1st 24 hrs. Nat. _____

1st 24 hrs. after shot _____

Gas _____ cu. ft.

Dry Hole _____

Abandoned _____

Lyon

Map No. *Kansas* Sec. *31* Twp. *21* R. *10*

Well No. *5 H Steys* Farm


Transcontinental Oil Company

..... Ft. from N. Line

990 Ft. from S. Line

330 Ft. from E. Line

..... Ft. from W. Line

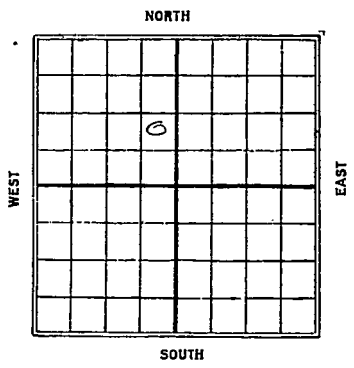

Date	REPORT
<i>1926</i>	
<i>6/2</i>	<i>Location</i>
<i>6/10</i>	<i>same</i>
<i>6/18</i>	<i>Bldg rig</i>
<i>6/25</i>	
<i>6/30</i>	<i>Rig</i>
<i>7/18</i>	<i>Spudding</i>
<i>7/15</i>	<i>Bldg 450</i>
<i>7/22</i>	<i>" 1100</i>
<i>7/28</i>	<i>" 1830</i>
<i>8/11</i>	<i>land 2093-2146</i>
	<i>Pay 2110-2135, 80/70 bbls</i>
	<i>T.D. 2146'</i>

K21 KANSAS Sec. 31 Twp. 21 R. 10

Well No. 57

McA Continental Co. Company

Contractor

FIRST REPORTS

SECTION PLAT

Ft. from N. Line

990 Ft. from S. Line

330 Ft. from E. Line

Ft. from W. Line

	o		

Location ✓

Rig up

Drilling and Remarks:

RECORD

Cased _____ in., _____ ft.

Sand _____

Gas _____

Oil _____

Total Depth _____

PRODUCTION

1st 24 hrs. Nat. _____

1st 24 hrs. after shot _____

Gas _____ Cu. Ft.

Dry Hole _____

Abandoned _____

Date

JUN 2 1926

CHAS. L. SHERWOOD

192

Scout

lyon

21 KANSAS Map No. Sec. 31 Twp. 21 R. 10

Well No. 5 A H type

Men & Co Continental Company

Contractor

COMPLETED

SECTION PLAT

Ft. from N. Line

990

Ft. from S. Line

330

Ft. from E. Line

Ft. from W. Line

	o		

Location

Rig up

Drilling and Remarks:

Key 2110-2135

Key 70 BS

RECORD

Cased in., ft.

Sand *2093-2146'*

Gas

Oil

Total Depth *2146*

PRODUCTION

1st 24 hrs. Nat.

1st 24 hrs. after shot

Gas Cu. Ft.

Dry Hole

Abandoned

Date

AUG 1 1 1926

CHAS. L. SHERWOOD

192

Scott