


Map No. Kanewas Sec. 31 Twp. 22 R. 10Well No. 5 Attygo FarmC. L. Sheedy Company

NORTH

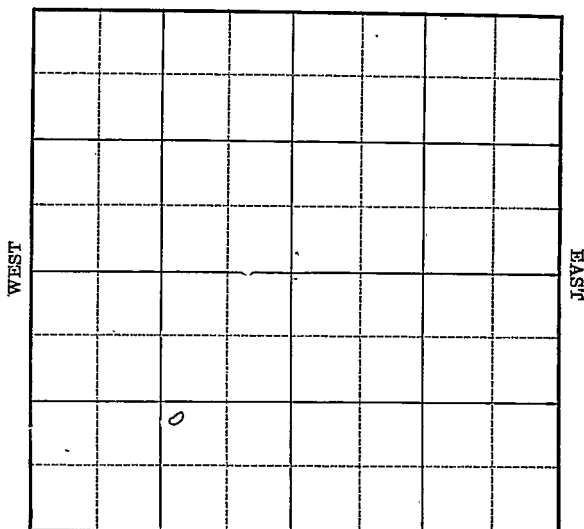

SOUTH

Location _____

Drilling Remarks _____

Rig Up _____

Drilling Remarks _____

RECORD

Cased _____ in. _____ ft.

Sand _____

Gas _____

Oil _____

Total Depth _____

PRODUCTION

1st 24 hrs. Nat. _____

1st 24 hrs. after shot _____

Gas _____ cu. ft.

Dry Hole _____

Abandoned _____

Lyons

Map No. _____ Sec. 31 Twp. 21 R. 10

Well No. 5 A types Farm


C.L. Shady Company

_____ Ft. from N. Line

990 Ft. from S. Line

990 Ft. from E. Line

_____ Ft. from W. Line

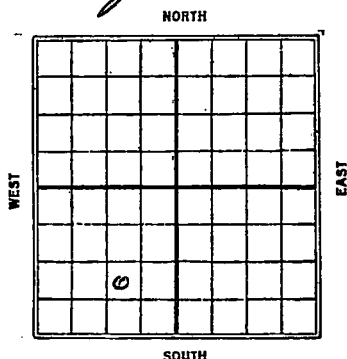

1926

Date REPORT

3/3	Timbers
3/10	Bldg rig.
3/18	Rig
3/25	Sh 300'
4/1	" 950
4/7	—
4/15	Drilling 1950
4/21	Top sand 2227-72'
	sandy shale 2272-2278.
	I.D. 2283' filled up 1200'
	natural. shot 100/swab.
	and Co.
4/27	2227-2272, I.D. 2283,
	100/100 Bbls.

1521 KANSAS Sec. 31 Twp. 21 R. 16

Well No. 5 types
C. L. Shedy Company

Contractor

SECTION PLAT

	0		

_____ Ft. from N. Line

990 Ft. from S. Line

990 Ft. from E. Line

_____ Ft. from W. Line

FIRST REPORTS

Location _____

Rig up _____

Drilling and Remarks:

RECORD

Cased _____ in., _____ ft.

Sand _____

Gas _____

Oil _____

Total Depth _____

PRODUCTION

1st 24 hrs. Nat. _____

1st 24 hrs. after shot _____

Gas _____ Cu. Ft.

Dry Hole _____

Abandoned _____

Date

MAR 3 1926

192

CHAS. L. SHERWOOD

Scout

Map No. *K21* KANSAS Sec. *31* Twp. *21* R. *10*

Well No. *5 atgeo*

Q L Shedy Company

Contractor

COMPLETED

SECTION PLAT

_____ Ft. from N. Line

990 Ft. from S. Line

990 Ft. from E. Line

_____ Ft. from W. Line

	o		

Location _____

Rig up _____

Drilling and Remarks:

100' 100' SS.

RECORD

Cased _____ in., _____ ft.

Sand *2227-2272'*

Gas _____

Oil _____

Total Depth *2283'*

PRODUCTION

1st 24 hrs. Nat. _____

1st 24 hrs. after shot _____

Gas _____ Cu. Ft.

Dry Hole _____

Abandoned _____

Date

APR 28 1926

192

CHAS. L. SHERWOOD

Scout