

Marion

Form 51-5M-9-28-27423

Map No. **KANSAS** Sec. 31 Twp. 21^S R. 4^E

Well No. 1 - Booth Farm

Consumers Oil Company

NORTH

						⊙	

WEST

EAST

SOUTH

Location.....

Drilling Remarks.....

.....

.....

Rig Up.....

Drilling Remarks.....

.....

.....

RECORD

PRODUCTION

Cased..... in..... ft.

1st 24 hrs. Nat.....

Sand.....

1st 24 hrs. after shot.....

Gas.....

Gas..... cu. ft.....

Oil.....

Dry Hole.....

Total Depth.....

Abandoned.....

Map No. Sec. Twp. R.

Well No. Farm


..... Company

..... Ft. from N. Line

..... Ft. from S. Line

..... Ft. from E. Line

..... Ft. from W. Line

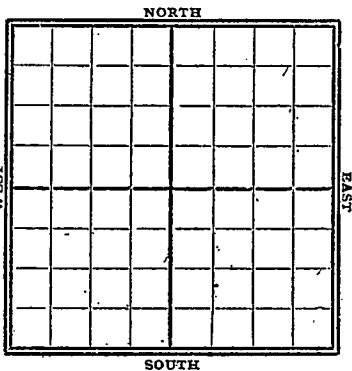

1920

Date

REPORT

Gypsy Records

9/20

Abd T.D. 2525'

Marion

FORM 26 250 BKS. 4-28 WESTERN

K23 MAP NO. KANSAS SEC. 31 TWP. 71S R. 4E

WELL No. 1

Consumer Oil COMPANY

CONTRACTOR

ABANDONED SECTION PLAT

_____ FT. FROM N. LINE
_____ FT. FROM S. LINE
_____ FT. FROM E. LINE
_____ FT. FROM W. LINE

4x4 grid section plat with a small circle in the top-right cell.

LOCATION _____

RIG UP _____

DRILLING AND REMARKS:

oil

RECORD

CASED _____ IN. _____ FT.

SAND _____

GAS _____

OIL _____

TOTAL DEPTH 2545

PRODUCTION

1ST 24 HRS. NAT. _____

1ST 24 HRS. AFTER SHOT _____

GAS _____ CU. FT.

DRY HOLE [checkmark]

ABANDONED [checkmark]

DATE Sept 20 1920

SCOUT