

Lyon

KANSAS

SECTION 32 TOWNSHIP 21 RANGE 12E

WELL NO. ~~#2 Harlan~~ #1 Polrona "A"

COMPANY Harold Ellis

NORTH

SOUTH

Lyon

KANSAS

SEC.	TWP.	R.
32	21	12E

WELL NO.

#2 Harlan

#1

Pdraua "A"

FARM

COMPANY

Harold Ellis

CONTRACTOR

Geneva

Fankhouser


Ft. from N. Line

Ft. from S. Line

Ft. from E. Line

Ft. from W. Line

SE SE SW

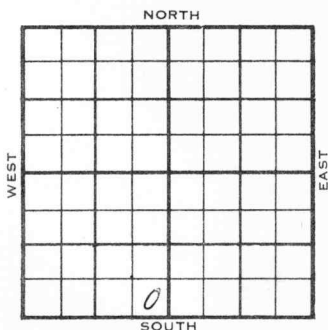

1956

ELEVATION

REPORT

4-11

Comm. 4-3-56
 8" @ 102 w/75
 4 1/2" @ 1848
 TD 1870
 Bart. 1847

4-25

CO 1870
 FU 1270' fluid, 50% wtr., 12 hrs.
 DD 1872-
 Frac
 Est P/ 20 BOPD / 20 BOPD
 TD 1872'

COMPLETED

County

Lyon

Elev.

Sec.

32

Twp.

21

Rge.

12E

Company

Harold Ellis

Farm Name

Harlan

No.

2

TOPS

DEPTH

LOG

DATUM

Loc. in Sec.

Anh.

Tp.

H.

Tr.

Dg.

Bl.

L.

K.C.

B.K.C.

Ce.

C.

M.

M.

K.

Mz.

Mq.

V.

S.

S.

A.

R.

P.E.

G.

T.D.

SE SE SW

Geol.

Contr.

Geneva

Pool

Fankhouser

FIRST REPORT

APR 11 1956

Date Comm.

4-3-56

8" @ 102/75

4 1/2" @ 1848

TD 1870

APR 11 1956

R.G.

CORRECTION

FORM 513 SUNRAY

No County Map

County Iron Elev. _____
 Sec. 32 Twp. 21 Rge. 12E
 Company Harold Ellis
 Farm Name ~~Harold Ellis~~ Pdrda "A" No. #1

TOPS	DEPTH	LOG	DATUM	Loc. in Sec.
Anh.				SE SE SW
Tr.				
H.				
Tr.				
Dg.				
Bl.				
L.				Geol. _____
K.C.				Contr. _____
B.K.C.				
Ce.				Geneva
C. <u>Bart.</u>	<u>1847</u>			
M.				Pool
M.				Fankhouser
K.				
Mz.				
Ma.				
V.				
S.				
S.				
A.				
R.				
Pe.				
G.				
T.D.	<u>1870</u>			

APR 25 1956

Date Comm. 4-3-56

8" @ 102/75 1 1/2" @ 1848 TD 1870 APR 18 '56

CO 1870 FU 1270' Fluid 50%
 WT 12 hrs DD 1872 Flac.

APR 25 '56 est P. 20 Bopd + 20 Bwpd