
FORM 51 10M 8-47 KANSAS Lyon

Section 32 Township 21 Range 11-E

Well No. 4 Murphy

Company Murphy et al

Miscellaneous

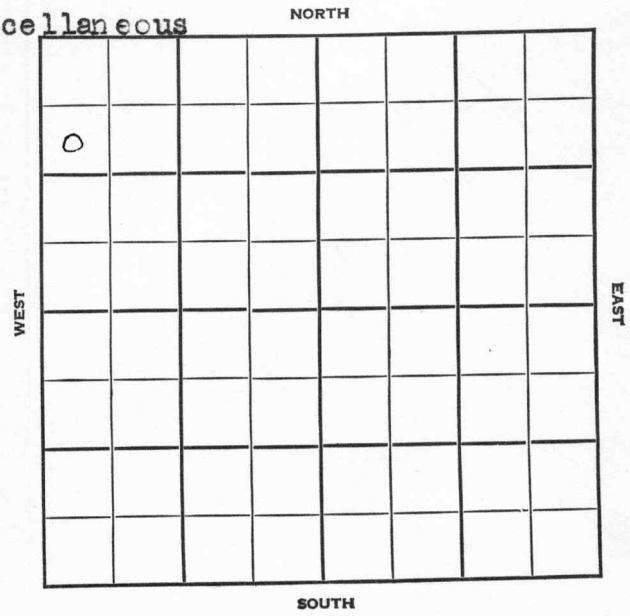

FORM 252-A
5M 9-47 PETROL

KANSAS Lyon

Sec. 32 Twp. 21 R. 11E

Well No. #4 Murphy Farm

Murphy et al Company

Misc.


990 Ft. from N. Line

Ft. from S. Line

Ft. from E. Line

330 Ft. from W. Line

SW NW NW

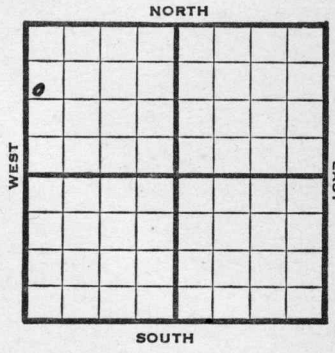

1947	Elev. - REPORT
10/8	12½" @ 115' Drlg. 775'
10/15	Drlg. 990'
10/22	8" @ 1007' 6" @ 1567' Drlg. 1600'
10/29	TD 1863' 5" @ 1842' RUST
11/5	"
11/12	"
11/19	"
11/25	TD 1868' 60 qts. 1842-68' WO
12/3	"
12/10	Bart 1842' 5" @ 1842' Pump 25 Pot Gr. 38° 0 Total Depth 1868'
	COMPLETED

Form 26 200 Bks. 10-46 Petrol

Miscellaneous

Kansas

Map No. _____ Sec. 32 Twp. 21 R. 11E

Well No. 4 Murphy

Murphy etal. Company

FIRST REPORT Contractor

SW NW NW


990 Ft. from N. Line

_____ Ft. from S. Line

_____ Ft. from E. Line

330 Ft. from W. Line

SECTION PLAT

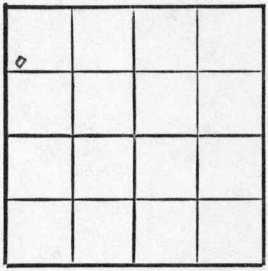

Lyon County

Location _____

Rig up _____

Drilling and Remarks:

12½" @ 115

drlg. 775

RECORD

Cased _____ in., _____ ft.

Sand _____

Gas _____

Oil _____

Total Depth _____

PRODUCTION

1st 24 hrs. Nat. _____

1st 24 hrs. after shot _____

Gas _____ Cu. Ft.

Dry Hole _____

Abandoned _____

Date

OCT 8 1947

19 _____ S. J. LEWIS Scout

Form 26 200 Bks. 10-46 Petrol

Kansas

Miscellaneous

Map No. 21 Sec. 32 Twp. 21 R. 11E

Well No. 4 Murphy

Murphy etal. Company

COMPLETE Contractor

SW NW NW


990 Ft. from N. Line

Ft. from S. Line

Ft. from E. Line

330 Ft. from W. Line

SECTION PLAT

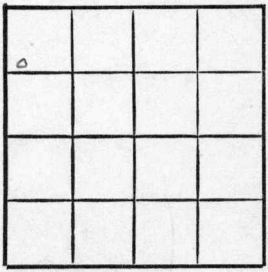

Lyon County

Location

Rig up

Drilling and Remarks:

Bar 1842

5" @ 1842

Pump 20 Bbl

8 Sx

RECORD

Cased in., ft.

Sand

Gas

Oil

Total Depth 1868

PRODUCTION

1st 24 hrs. Nat.

1st 24 hrs. after shot

Gas Cu. Ft.

Dry Hole

Abandoned

Date

DEC 10 1947 19

S. J. LEWIS Scout