




Section 32 Township 21 Range 11E

Well No. #5 Fee

Company Murphy

Miscellaneous

NORTH

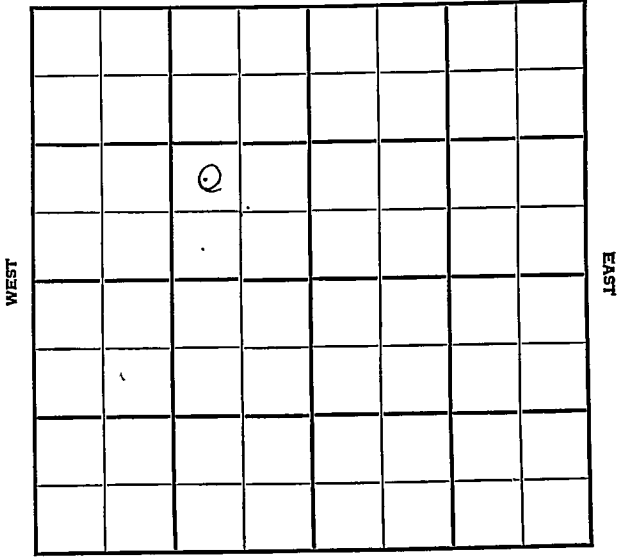

SOUTH



Sec. 32 Twp. 21 R. 11E

Well No. #5 Fee Farm

Murphy Company


Misc.

 Ft. from N. Line

990 Ft. from S. Line

990 Ft. from E. Line

 Ft. from W. Line

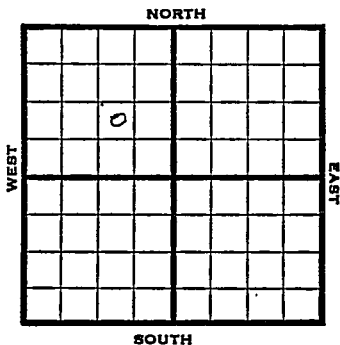

NW SE NW

1948	Elev. - REPORT
-	
4/14	12" @ 45' 10" @ 535' Drlg. 550'
4/21	"
4/28	SD
5/5	"
5/12	"
5/19	Sand 1879' TD 1902' ABANDONED

Map No. _____ Sec. 32 Twp. 21 R. 11E

Well No. 5 Fee

Murphy Company

FIRST REPORT Contractor

NW SE NW

SECTION PLAT

_____ Ft. from N. Line

990 Ft. from S. Line

990 Ft. from E. Line

_____ Ft. from W. Line

	o		

Lyon County

Location _____

Rig up _____

Drilling and Remarks:

12" @ 45

10" @ 535

drlg. 550

RECORD

Cased _____ in., _____ ft.

Sand _____

Gas _____

Oil _____

Total Depth _____

PRODUCTION

1st 24 hrs. Nat. _____

1st 24 hrs. after shot _____

Gas _____ Cu. Ft.

Dry Hole _____

Abandoned _____

Date

APR 14 1948 19 _____ S. J. LEWIS Scout

