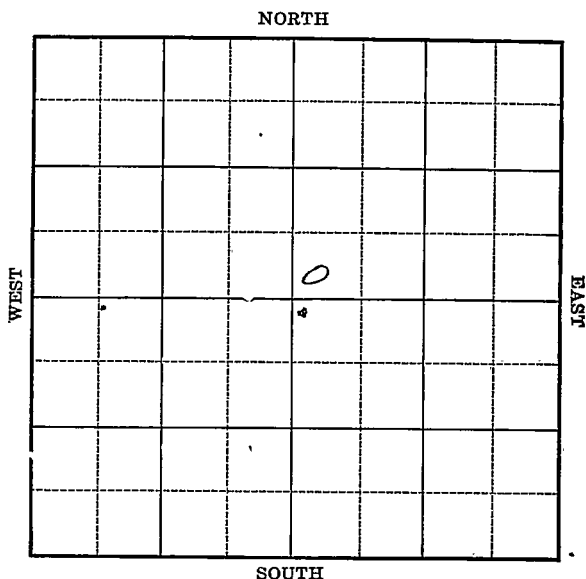


Map No. Kansas Sec. 32 Twp. 21 R. 10Well No. 1 Jones FarmSouthwestern Pub Company

Location _____

Drilling Remarks _____

RECORD

Cased _____ in. _____ ft.

Sand _____

Gas _____

Oil _____

Total Depth _____

Rig Up _____

Drilling Remarks _____

PRODUCTION

1st 24 hrs. Nat. _____

1st 24 hrs. after shot _____

Gas _____ cu. ft.

Dry Hole _____

Abandoned _____

Map No. Kansas Sec. 32 Twp. 21 R. 10Well No. 1 Jones FarmSouthwestern Pet Company

NORTH

WEST

EAST

SOUTH

Ft. from N. Line

700 Ft. from S. Line

Ft. from E. Line

700 Ft. from W. Line

Date

REPORT

9/25	
9/3	Rig up
9/11	spudding
9/16	only 500'
9/24	✓ 900'
10/1	✓ 1600
10/8	Sand 2212-2247 Dry 4 1/2" C 2205
	Drbg 2247
10/16	Tap first Break 2375-90
	only 2445
10/22	_____
10/29	_____
11/6	log @ 2445
11/13	U.R. 6" ID. 2445
11/19	_____
11/27	_____
12/3	only 2530 h.o.b. Obon.
12/10	_____
12/17	_____
12/23	_____
12/31	_____
1926	_____
1/8	_____

$\frac{1}{14}$ - same

$\frac{1}{20}$ - Abandoned 2666

Map No. 21 KANSAS Sec. 32 Twp. 21 R. 10
 Well No. 1 Jones
Routhwaite Co. Company

Contractor

FIRST REPORTS

SECTION PLAT

Ft. from N. Line

200

Ft. from S. Line

Ft. from E. Line

200

Ft. from W. Line

Location

Rig up ✓

Drilling and Remarks:

RECORD

Cased _____ in., _____ ft.

Sand _____

Gas _____

Oil _____

Total Depth _____

PRODUCTION

1st 24 hrs. Nat. _____

1st 24 hrs. after shot _____

Gas _____ Cu. Ft.

Dry Hole _____

Abandoned _____

Date

SEP 3 1925

192

CHAS. L. SHERWOOD

Scout

Returned

Cards

Tracing

France Map

Scarborough Map

Moody Map

Scarborough Plat Book

Moody Plat Book

Superior Co

R21

Map No. KANSAS Sec. 32 Twp. 21 R. 10

Well No. 1 Jones

Panthwestern Oil Co

Company

Contractor

COMPLETED

SECTION PLAT

		0	
		.	
			.

Ft. from N. Line

200

Ft. from S. Line

Ft. from E. Line

200

Ft. from W. Line

ABANDONED

Location

Rig up

Drilling and Remarks:

Top line 2205'

Drill hole 2212-47'

1st Blow 2375'

Drill 2 47'

T.D. 2666'

RECORD

Cased _____ in., _____ ft.

Sand _____

Gas _____

Oil _____

Total Depth 2666'

PRODUCTION

1st 24 hrs. Nat. _____

1st 24 hrs. after shot _____

Gas _____ Cu. Ft.

Dry Hole ☒Abandoned ☒

Date

JAN 20 1926

192 CHAS. L. SHERWOOD

Scout

Returned	
Cards	<i>[initials]</i>
Tracing	<i>[initials]</i>
France Map	<i>[initials]</i>
Scarborough Map	<i>[initials]</i>
Moody Map	<i>[initials]</i>
Scarborough Plat Book	<i>[initials]</i>
Moody Plat Book	