

Map No. Sec. Twp. R.

Well No. Farm


..... Company

..... Ft. from N. Line

..... Ft. from S. Line

..... Ft. from E. Line

..... Ft. from W. Line

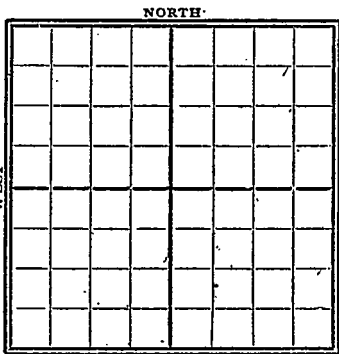

1923

Date

REPORT

Gypsy Records

6/12

Abd T.O. 2532'

Marion
 K23 MAP NO. KANSAS SEC. 32 TWP. 21S R. 4E

WELL NO. 1 Northington
Morgan et al COMPANY

CONTRACTOR

ABANDONED

SECTION PLAT

			0

_____ FT. FROM N. LINE

_____ FT. FROM S. LINE

_____ FT. FROM E. LINE

_____ FT. FROM W. LINE

No Record

LOCATION _____

RIG UP _____

DRILLING AND REMARKS:

*nothing
in
holes*

RECORD

CASED _____ IN. _____ FT.

SAND _____

GAS _____

OIL _____

TOTAL DEPTH 955 ✓

PRODUCTION

1ST 24 HRS. NAT. _____

1ST 24 HRS. AFTER SHOT _____

GAS _____ CU. FT.

DRY HOLE

ABANDONED

DATE

6/15 3

192

SCOUT