


Section 33 Township 21 Range 1E

Well No. #1 Brown

Company W. R. Atkinson et al

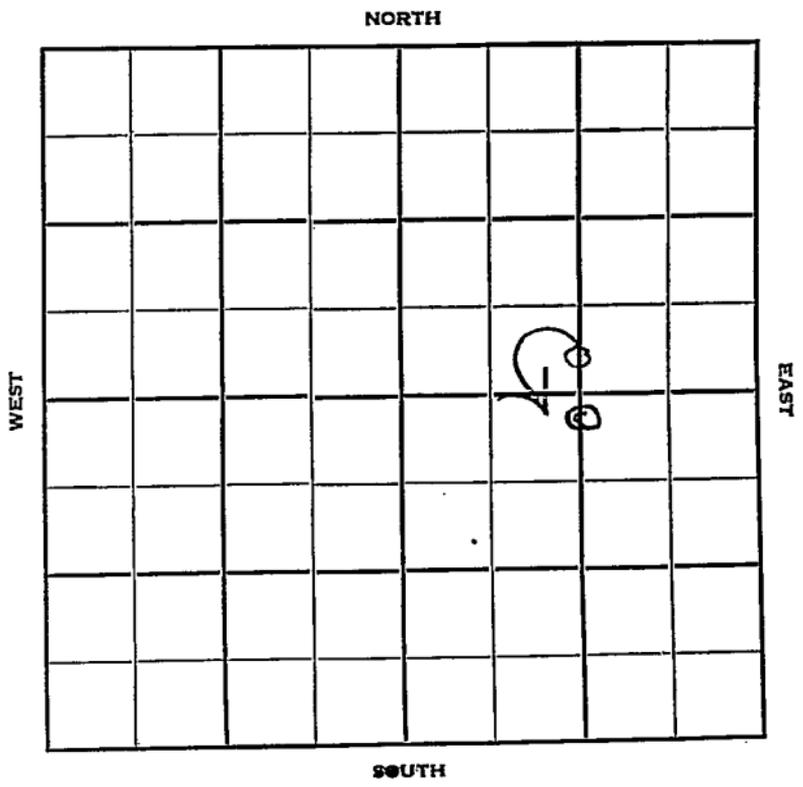

Marion

KANSAS

Sec. 33 Twp. 21 R. 4E

Well No. #1 Brown Farm

W. R. Atkinson et al Company

Uhl Drlg. Contractor


Wildcat

_____ Ft. from N. Line

330 Ft. from S. Line

~~1200~~
~~1320~~ Ft. from E. Line

_____ Ft. from W. Line

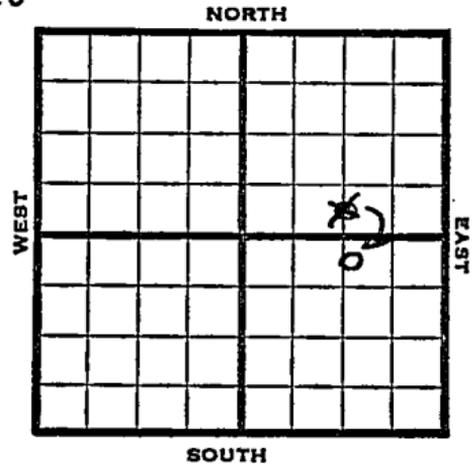

~~C S L S/2 NE~~
C N L N/2 SE

1951 Elev. 1370' REPORT

12/5 Spud 11-30-51
8" @ 105'

2/6 Spud 11-30-51
 Oil Well TD 2503
 8" @ 105 KC 1776
 Miss 2268
 DST 2268-75 opn 1 hr Rec. 26' mud
 Kh 2330 Chat 2466 Misener 2484
 Viola 2487 TD 2503 5" @ 2336
 Perf/2269-75 FU 250' oil & wtr 12 hr..
 B/2 gw 2 goph Hydra.
 Comp. 3 bopd

COMPLETED

County Marion State Kansas

Sec. 33 (Blk. 21 (Twp. 4E (Sur. 4E (Rge. 4E Map No.

Operator W. R. Atkinson et al.

Well No. 1 Farm Brown

Elev. _____ Location C S L S $\frac{1}{2}$ NE

330' Ft. From S Line NE

1320 Ft. From E Line Quarter

1st. Report DEC 5 1951

Completion _____

Remarks _____

Uhl Drlg. - Contr.

Spudding Date 11-30-51

Drlg. Data Wildcat

8" @ 105

Map No. _____ Sec. 33 Twp. 21 R. 4E

Well No. 1 Brown

W. R. Atkinson et al. Company

CONFECTION Contractor

C N L $N\frac{1}{2}$ SE


SECTION PLAT

_____ Ft. from N. Line

330 Ft. from S. Line

1200 Ft. from E. Line

_____ Ft. from W. Line

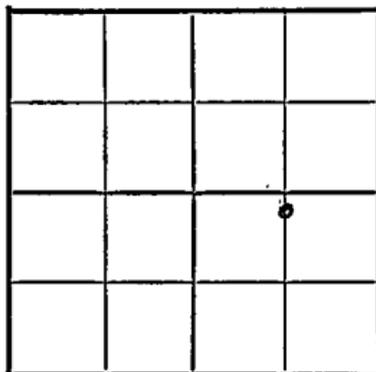

Marion County

Location _____

Rig up _____

Drilling and Remarks:

Reported

C S L $S\frac{1}{2}$ NE


RECORD

Cased _____ in., _____ ft.

Sand _____

Gas _____

Oil _____

Total Depth _____

PRODUCTION

1st 24 hrs. Nat. _____

1st 24 hrs. after shot _____

Gas _____ Cu. Ft.

Dry Hole _____

Abandoned _____

Date

JAN 9 1952 19

J. E. TYRA

Scout

