

Section 33 Township 21 Range 3 EWell No. # 1 HaleCompany Adair Oil

							0

NORTH

WEST

EAST

SOUTH

WELL NO.

1 Hale

FARM

COMPANY

Adair Oil

CONTRACTOR

Adair

Wildcat


330 Ft. from N. Line

Ft. from S. Line

330 _____ Ft. from E. Line

Ft. from W. Line

NE NE NE

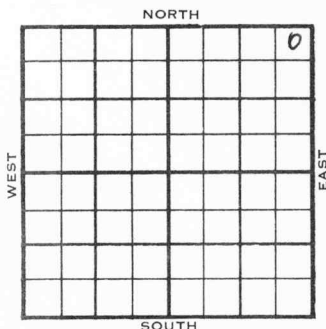

ELEVATION

1405'

REPORT

1954

4/7

Location

4/21

Spud 4-8-54 D & A TD 2955
8" @ 136 Lans. 1963 Marm 2271
Miss. 2542 Kh. 2684 Hunton 2820
Maq. 2870 Viola 2884 Simp sd 2936
Simp. dol. 2940 TD 2955 D & A

ABANDONED

J. G. McGEHEE

