


Lyon ✓

Map No. Kansai Sec. 33 Twp. 21 R. 12

Well No. 11 Pedrosa Farm

Phillips Pet Company

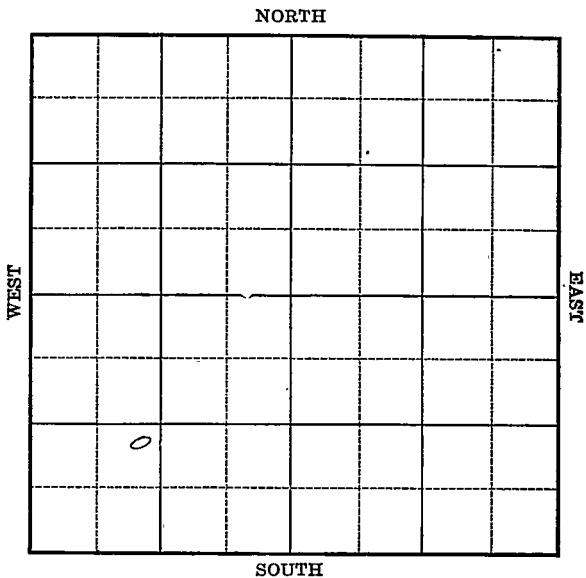

Location _____

Rig Up _____

Drilling Remarks _____

Drilling Remarks _____

RECORD

PRODUCTION

Cased _____ in. _____ ft.

1st 24 hrs. Nat. _____

Sand _____

1st 24 hrs. after shot _____

Gas _____

Gas _____ cu. ft.

Oil _____

Dry Hole _____

Total Depth _____

Abandoned _____

Map No. *K 1000* Sec. *33* Twp. *21* R. *12*


Well No. *# 11 Pedroza* Farm
Phillips Pet Company

..... Ft. from N. Line

990 Ft. from S. Line

..... Ft. from E. Line

990 Ft. from W. Line

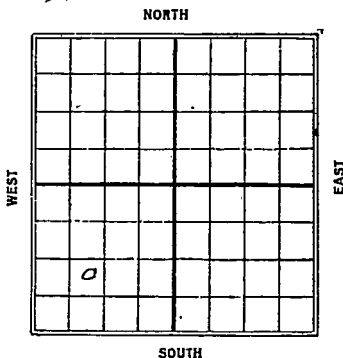

1926.

Date

REPORT

<i>5/19</i>	<i>Rign.</i>
<i>6/12</i>	<i>drp. 1700</i>
<i>6/9</i>	<i>Sand 1895-1948 180 gte</i>
	<i>100 bbls</i>

K-21 **KANSAS** *33* *Hyon*
Map No. _____ Sec. _____ Twp. *21* R. *12*

Well No. *11 Red Roza* _____
Phillips Oil Co _____

Company

Contractor

FIRST REPORTS

SECTION PLAT

_____ Ft. from N. Line

990 _____ Ft. from S. Line

_____ Ft. from E. Line

990 _____ Ft. from W. Line

<i>0</i>			

Location _____

Rig up _____

Drilling and Remarks:

RECORD

Cased _____ in., _____ ft.

Sand _____

Gas _____

Oil _____

Total Depth _____

PRODUCTION

1st 24 hrs. Nat. _____

1st 24 hrs. after shot _____

Gas _____ Cu. Ft.

Dry Hole _____

Abandoned _____

Date

MAY 12 1926

192

CHAS. L. SHERWOOD

Scout

Hyon Co

Map No. *K21* KANSAS Sec. *33* Twp. *21* R. *12*

Well No. *11 Redroza*
Phillips pet Co Company

Contractor

COMPLETED

SECTION PLAT

----- Ft. from N. Line

990 Ft. from S. Line

----- Ft. from E. Line

990 Ft. from W. Line

<i>0</i>			

Location -----

Rig up -----

Drilling and Remarks:

at 1908'

1807 100 lbs.

RECORD

Cased *1895-1948* in., ft.

Sand -----

Gas -----

Oil -----

Total Depth *1948*

PRODUCTION

1st 24 hrs. Nat. -----

1st 24 hrs. after shot -----

Gas ----- Cu. Ft.

Dry Hole -----

Abandoned -----

Date

JUN 9 1926

----- 192

CHAS. L. SHERWOOD

Scout