

Marion

KANSAS

34

21S

4E

SECTION _____ TOWNSHIP _____ RANGE _____


#1 Guertzen

WELL NO. _____

COMPANY East August Oil

NORTH

NE NE SW

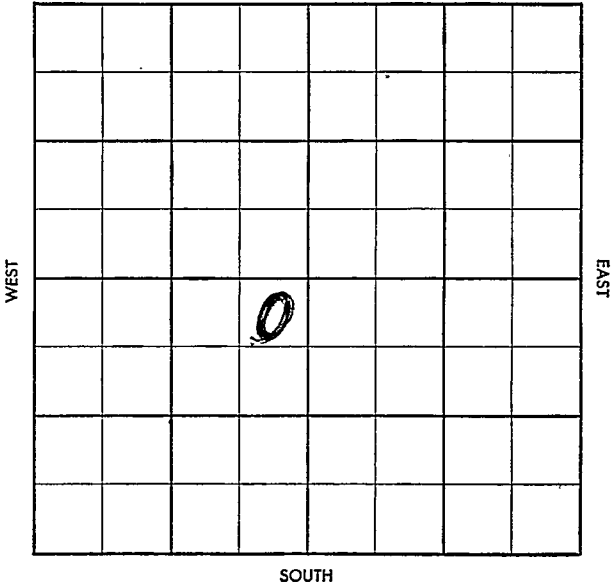

~~NO~~
WILDCAT

S-513-A

CO. ~~Marion~~ ELEV. _____
SEC. ~~34~~ TWP. ~~21~~ RGE. ~~4E~~
COMPANY ~~East August Oil~~ NO. ~~1~~

FIRST REPORT	

FARM ~~Guertzen~~
LOC. ~~NE NE SW~~

Lans. 1740	

GEOL. _____
CONTR. ~~Co. Tools~~
POOL ~~Wildcat~~
SPUD ~~10-17-57~~
~~8" @ 145, Doug 1620~~
~~Drlg. 1905.~~

NO.
SEC.
TWP.
RGE.

~~NO~~

S-513-A

CO. ~~Marion~~ ELEV. _____
SEC. ~~34~~ TWP. 21 RGE. 4E
COMPANY East August Oil No. 1

ABANDONED
NOV 27 '57

FARM Guertzen

LOC. NE NE SW

~~X~~

Lans. 1740
RC 1910
M 2289
V 2537

TD 2549

GEOLOGICAL
CONTR. Co. Tools
POOL Wildcat
SPUD 10-17-57
8" c 145, Doug. 1620
Drlg. 1905. " "
NOV '57 DST 2289
- 2300 45" 75'
OCM BHP 40
5" 2360 w x

CO. 22/2290-99
autilze 1200A 590 12 hrs
TD 2549

DBA

CO. NO. SEC. TWP. RGE.