


Section 34 Township 21 Range 2-E

Well No. #1 Wallace

Company Aladdin Pet.

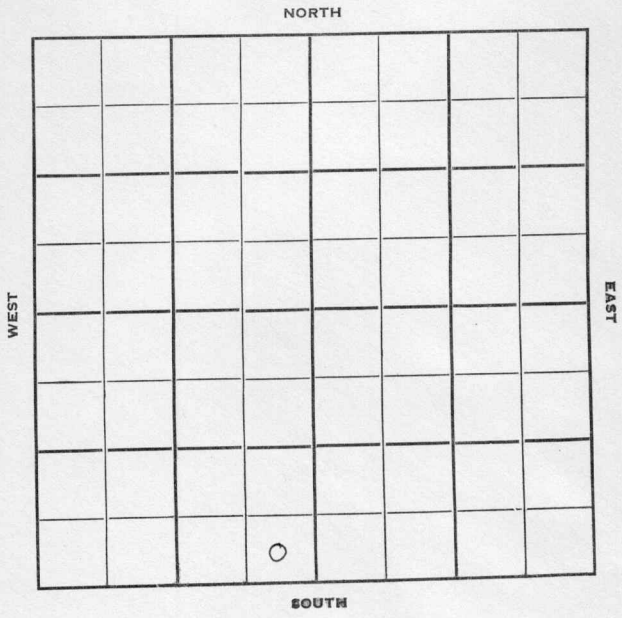

Marion

Sec. 34 Twp. 21 R. 2E

Well No. #1 Wallace Farm

Aladdin Pet. Company

Wildcat Contractor


 Ft. from N. Line

330' Ft. from S. Line

330' Ft. from E. Line

 Ft. from W. Line

SE SE SW

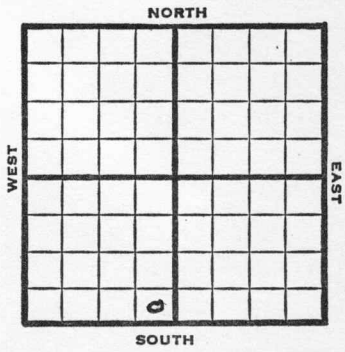

1950 Elev 1434 REPORT

8/23 Location

9/6	8 5/8" @ 170	
	Howard	Top 1498
	Heeb 1834	B. Oread 1878
	Burgess 2717	Miss 2735
	Kinderhook 2939	Hunton 3058
	Maq 3109	Viola 3135
	Simp 3194	Arg 3257
	TD 3307	
	D&A	

ABANDONED

