


Map No. Kansas Sec. 34 Twp. 21 R. 10Well No. 3 Purple Farm  
Ritchie & Moore Company

NORTH

WEST

EAST

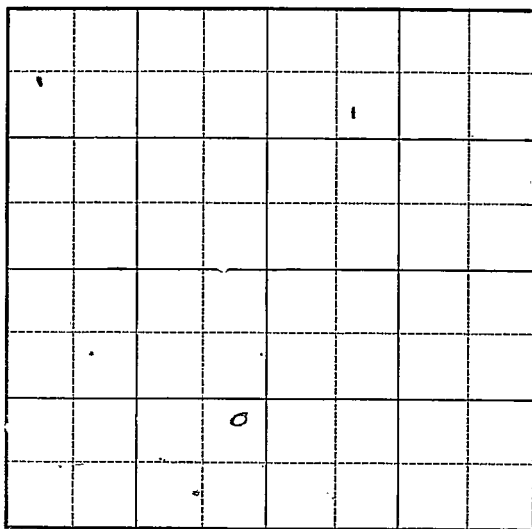

SOUTH

Location \_\_\_\_\_

Drilling Remarks \_\_\_\_\_

Rig Up \_\_\_\_\_

Drilling Remarks \_\_\_\_\_

## RECORD

Cased \_\_\_\_\_ in. \_\_\_\_\_ ft.

Sand \_\_\_\_\_

Gas \_\_\_\_\_

Oil \_\_\_\_\_

Total Depth \_\_\_\_\_

## PRODUCTION

1st 24 hrs. Nat. \_\_\_\_\_

1st 24 hrs. after shot \_\_\_\_\_

Gas \_\_\_\_\_ cu. ft.

Dry Hole \_\_\_\_\_

Abandoned \_\_\_\_\_

Map No. Kansas Sec. 34 Twp. 21 R. 10  
 Well No. 2 Purlee Farm  
Ritchie and Moore Company

NORTH

WEST

EAST

SOUTH

Ft. from N. Line

990 Ft. from S. Line

330 Ft. from E. Line

Ft. from W. Line

Date

REPORT

1925

12/17 Location

12/23 Rig

12/31

1926

1/8 Rig

1/4 Dlg 600'

3/0 ✓ 1085'

1/2 ✓ 1750'

3/4 Top line 2157' 6" 2160'

D lg 2290'.

3/10 Top line 2157' showed

2188-96' Dlg 2510'

2/17 S. &amp; A. 2612

Hurons Co

R21 KANSAS 34 Twp. 21 R. 10  
 Map No. Sec. 34  
 Well No. 2 Fix 6  
 Ritchie & Mool Company

Contractor

## COMPLETED

## SECTION PLAT

|  |  |  |  |
|--|--|--|--|
|  |  |  |  |
|  |  |  |  |
|  |  |  |  |
|  |  |  |  |
|  |  |  |  |
|  |  |  |  |
|  |  |  |  |
|  |  |  |  |

Ft. from N. Line

990 Ft. from S. Line

330 Ft. from E. Line

Ft. from W. Line

## ABANDONED

Location

Rig up

Drilling and Remarks:

Top 2157'

Show 2188-96'

Dry &amp; whd

ID 2612'

Top with cox 2608-10 1/2'

## RECORD

Cased \_\_\_\_\_ in., \_\_\_\_\_ ft.

Sand \_\_\_\_\_

Gas \_\_\_\_\_

Oil \_\_\_\_\_

Total Depth 2612'

## PRODUCTION

1st 24 hrs. Natr. \_\_\_\_\_

1st 24 hrs. after shot \_\_\_\_\_

Gas \_\_\_\_\_ Cu. Ft.

Dry Hole \_\_\_\_\_

Abandoned \_\_\_\_\_

Date

FEB 17 1926

192


CHAS. L. SHERWOOD

Scout

Map No. KANSAS 34 Sec. 21 Twp. 10 R. 10  
 Well No. 2 Pipe  
Hutchins and Moore Company  
 Contractor

## SECTION PLAT

\_\_\_\_\_ Ft. from N. Line  
990 Ft. from S. Line  
330 Ft. from E. Line  
 \_\_\_\_\_ Ft. from W. Line

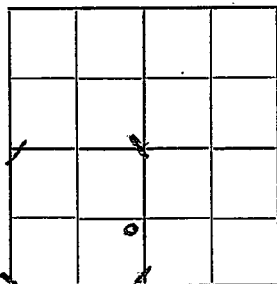

## FIRST REPORTS

Location ☒ \_\_\_\_\_  
 Rig up \_\_\_\_\_  
 Drilling and Remarks:

## RECORD

Cased \_\_\_\_\_ in., \_\_\_\_\_ ft.  
 Sand \_\_\_\_\_  
 Gas \_\_\_\_\_  
 Oil \_\_\_\_\_  
 Total Depth \_\_\_\_\_

## PRODUCTION

1st 24 hrs. Nat. \_\_\_\_\_  
 1st 24 hrs. after shot \_\_\_\_\_  
 Gas \_\_\_\_\_ Cu. Ft.  
 Dry Hole \_\_\_\_\_  
 Abandoned \_\_\_\_\_

Date

DEC 17 1925 CHAS. L. SHERWOOD  
 192 Scout