


Map No. K Sec. 34 Twp. 21 R. 10

Well No. J. Mc Bray Farm _____
Buck Echal Company _____

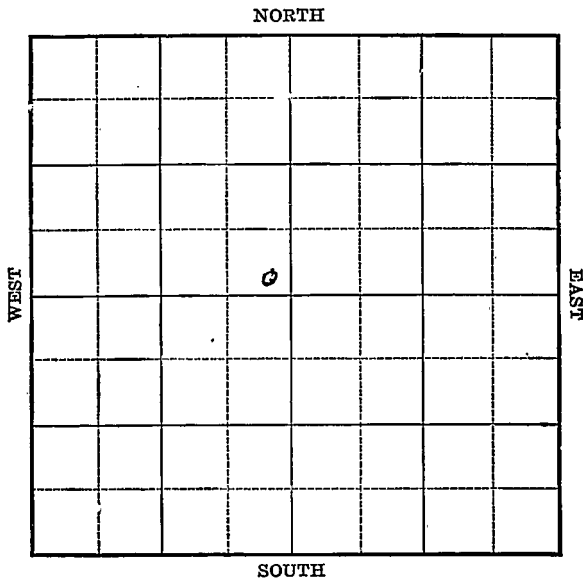

Location _____

Rig Up _____

Drilling Remarks:

Drilling Remarks:

RECORD

PRODUCTION

Cased _____ in. _____ ft.

Sand _____

Gas _____

Oil _____

Total Depth _____

1st 24 hrs. Nat. _____

1st 24 hrs. after shot _____

Gas _____ cu. ft.

Dry Hole _____

Abandoned _____

Map No. **KANSAS 21** Sec. **34** Twp. **21** R. **10**

Well No. **#1 McCoy**

Buckshot Company

Contractor

ABANDONED SECTION PLAT

_____ Ft. from N. Line

200 Ft. from S. Line

200 Ft. from E. Line

_____ Ft. from W. Line

		0	

Location _____

Rig up _____

Drilling and Remarks:

**Loya
2245'**

RECORD

Cased _____ in., _____ ft.

Sand _____

Gas _____

Oil _____

Total Depth _____

PRODUCTION

1st 24 hrs. Nat. _____

1st 24 hrs. after shot _____

Gas _____ Cu. Ft.

Dry Hole _____

Abandoned _____

Date

MAR 14 1924

192

M. A. BENEAR

Scout

Map No. Lyon 110 Sec. 34 Twp. 21 R. 10

Well No. 1 - 2nd Cray

Company _____

Contractor _____

FIRST REPORT

SECTION PLAT

_____ Ft. from N. Line

207 Ft. from S. Line

209 Ft. from E. Line

_____ Ft. from W. Line

	.		
	'	o	

RECORD

Location _____

Rig up 1 1/2

Drilling and Remarks:

Cased _____ in., _____ ft.

Sand _____

Gas _____

Oil _____

Total Depth _____

PRODUCTION

1st 24 hrs. Nat. _____

1st 24 hrs. after shot _____

Gas _____ Cu. Ft.

Dry Hole _____

Abandoned _____

Date

JAN 15 1924

M. A. BENEAR