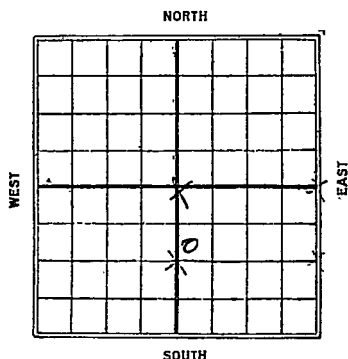


Map No. _____ Sec. 34 Twp. 121 R. 10Well No. 1 Ripley Farm _____Titus et al Company _____990 Ft. from N. Line

_____ Ft. from S. Line

_____ Ft. from E. Line

330' Ft. from W. Line19526

REPORT

1/8 Bldg Rig1/4 Rig1/20 _____1/8 Drlg 810'3/4 ✓ 1050'3/10 Running 10" 1550'2/17 Top line 2164' Drlg 2224'
small show oil.2/2 Abandoned 2250

1221 KANSAS, 34 Sec. 21 Twp. 10
 Map No. _____
 Well No. 1 Rig by
 Titus of Hh Company

Contractor

COMPLETED

SECTION PLAT


990 Ft. from N. Line

_____ Ft. from S. Line

_____ Ft. from E. Line

330 Ft. from W. Line

ABANDONED

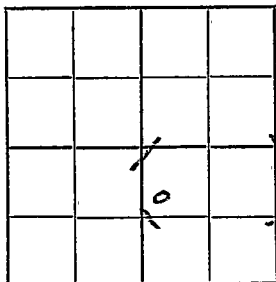

Location _____

Rig up _____

Drilling and Remarks:

Top line 2164

2224'

420y show oil

Dry 2 hrs

RECORD

Cased _____ in., _____ ft.

Sand _____

Gas _____

Oil _____

Total Depth 2250

PRODUCTION

1st 24 hrs. Nat. _____

1st 24 hrs. after shot _____

Gas _____ Cu. Ft.

Dry Hole ✓

Abandoned ✓

Date

MAR 3 1926

192

CHAS. L. SHERWOOD

Scout

Hyson Co
 71 KANSAS 34 Twp. 21 R. 10
 Map No. Sec. Twp. R.
 Well No. 1 *Pixley*
Titus of HL Company

Contractor

FIRST REPORTS


SECTION PLAT

990 Ft. from N. Line

_____ Ft. from S. Line

_____ Ft. from E. Line

330 Ft. from W. Line

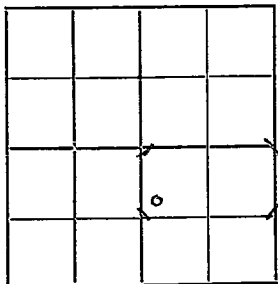

Location _____

Rig up _____

Drilling and Remarks:

Block Log

RECORD

Cased _____ in., _____ ft.

Sand _____

Gas _____

Oil _____

Total Depth _____

PRODUCTION

1st 24 hrs. Nat. _____

1st 24 hrs. after shot _____

Gas _____ Cu. Ft.

Dry Hole _____

Abandoned _____

Date

JAN 8 1926

CHAS. L. SHERWOOD

Scout