


Marion

KANSAS

SECTION 35 TOWNSHIP 21S RANGE 4E

WELL NO. #3 Ireland

COMPANY Geo. Johnston Jr.

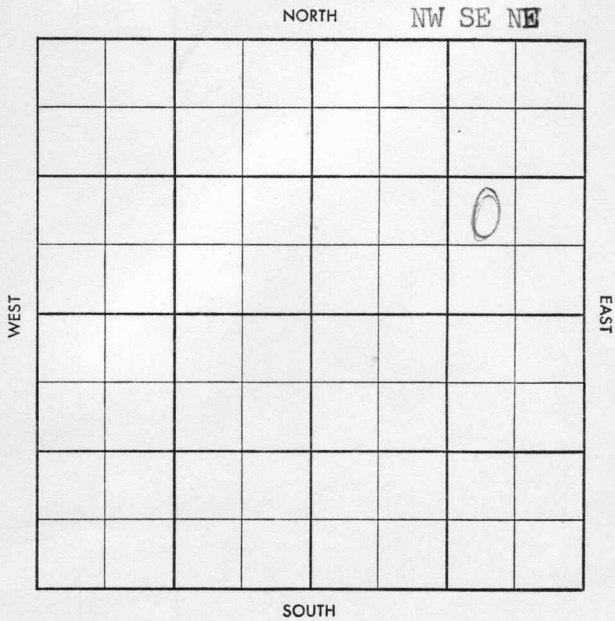

40

S-513-B

County Marion Elev. _____
 Sec. 35 Twp. 21 Rge. 4E
 Company Geo. Johnston Jr.
 Farm Name Ireland No. 3

TOPS	DEPTH	LOG	DATUM
Anh.			
Tp.			
H.			
Tr.			
Dg.			
B. L.			
L.			
K.C.			
B.K.C.			
Ce.			
C.			
M.			
M.			
K.			
Mz.			
Mq.			
V.			
S.			
S.			
A.			
R.			
Pf.			
G.			
T.D.			

Loc. in Sec. NW SE NE
 Geol. _____
 Contr. White & Ellis
 Pool Fairplay



Date Comm. _____
MIRT

Co.
Lse.
No.
Sec.
T.
R.

County Marion Elev. 1416 D⁷³
 Sec. 35 Twp. 21 Rge. 4E 1419 RB
 Company Geo. Johnston Jr.
 Farm Name Ireland No. 3

TOPS	DEPTH	LOG	DATUM
Anh.			
Tp.			
H.			
Tr.			
Dg.			
B.L.			
L.	<u>1776</u>	<u>1767</u>	
K.C.			
B.K.C.			
Ce.			
C.			
M.	<u>2270</u>	<u>2261</u>	
M.			
K.	<u>2347</u>	<u>2320</u>	
Mz.			
Ma.	<u>2471</u>	<u>2467</u>	
V.	<u>2476</u>	<u>2502</u>	
S.	<u>2591</u>		
A.			
R.			
Pf.			
G.			
T.D.	<u>2613</u>		

Loc. in Sec. NW SE NE
 Geol. _____
 Contr. _____
White & Ellis
 Pool _____
Fairplay

FEB 19 58
 ABANDONED

Date Comm. 2-5-58 FEB 19 58
 MIRT FEB 12 58 9"205
2468-78 60" 790 SW
BHP 865.

D&A

D&A