


Section 35 Township 21 Range 10 E

Well No. # 1 Brislen

Company John Richard

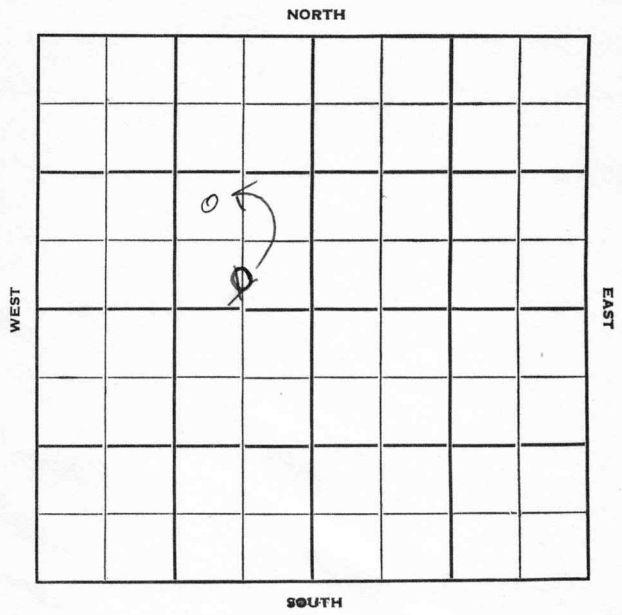

Sec. 35 Twp. 21 R. 10 E

Well No. # 1 Brislen Farm

John Richard Company

White & Ellis Contractor

_____ Ft. from N. Line

900
330


_____ Ft. from S. Line

990
660

_____ Ft. from E. Line

_____ Ft. from W. Line

~~C S 1/2 SE NW~~
NW SE NW

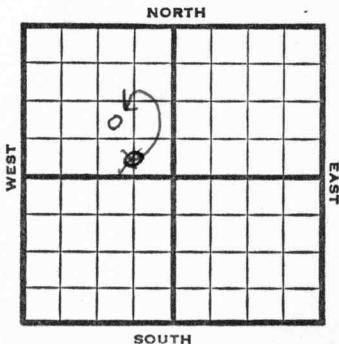

1952

Elev. -

REPORT

3/5

Moving in

3/26

Spud 3-6-52

D & A TD 2150' 8" @ 84

Lost hole at 1150 Skid rig

8" @ 98 Miss 2101-50' TD

D & A

ABANDONED

APR 2 1952

Scout Cards	<i>mm</i>
Land Small Map	
Land Wall Map	<i>33</i>
Tracings	
Frame Map	
Piece Map	
Misc	

Orig. Data

Kansas

Map No. _____ Sec. 35 Twp. 21 R. 10E

Well No. 1 Brislen

John Richard Company

CONSTRUCTION Contractor

NW SE NW

SECTION PLAT

_____ Ft. from N. Line
990 Ft. from S. Line
990 Ft. from E. Line
_____ Ft. from W. Line

	0		

Lyon County

Location _____

Rig up _____

Drilling and Remarks:

Reported

C S L SE NW

RECORD

Cased _____ in., _____ ft.
Sand _____
Gas _____
Oil _____
Total Depth _____

PRODUCTION

1st 24 hrs. Nat. _____
1st 24 hrs. after shot _____
Gas _____ Cu. Ft.
Dry Hole _____
Abandoned _____

Date

MAR 19 1952 19

J. G. McGEHEE

Scout

Kansas

FORM 28 REVERSE
200 HAS. 7-51

Map No. _____ Sec. _____ Twp. _____ R. _____

Well No. _____

Company _____

Contractor _____

EXPLANATION

SECTION PLAT

		5	

_____ Ft. from N. Line

_____ Ft. from S. Line

_____ Ft. from E. Line

_____ Ft. from W. Line

Year _____

RECORD

_____ in _____

_____ Cased

_____ Sand

_____ Gas

_____ Oil

Location _____

Rig up _____

Drilling and _____

MAR 21 1952

Scout Cards	_____
Land Small Map	_____
Land Wall Map	_____
Tracings	_____
France Map	_____
Pierce Map	_____
Misc.	_____

Date _____

J. G. McGEHEE

Scout _____

MAR 18 1952


County **Lyon** State **Kansas**

Sec. **35** (Blk. Twp.) **21** (Sur. Rge.) **10E** Map No.

Operator **John Richard**

Well No. **1** Farm **Brisben**

Elev. _____ Location **C S/2 SE NW**

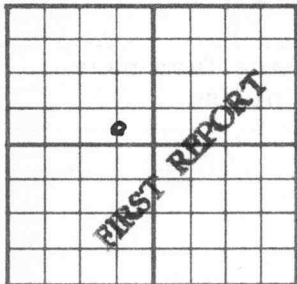

330 Ft. From **S** Line **NW**

660 Ft. From **E** Line Quarter

1st. Report **MAR 5 1952**

Completion _____

Remarks _____

White & Ellis - Contr.

Spudding Date _____

Drlg. Data _____

MI

J. G. MCGEHEE

XXXXXXXXXXXX
Farm name

XXXXXXXXXXXX well number XXXXXXXX
and well number No please

XXXXXX

Sam

Please let us have the farm name
and well number on ticket please

Sam

Scout Cards	mm
Land Small Map	
Land Wall Map	33
Tracings	
France Map	
Pierce Map	
Misc.	

MAR 14 1952