




Map No. \_\_\_\_\_ Sec. 35 Twp. 21 R. 7  
 Well No. 2 Armstrong Farm \_\_\_\_\_  
Selby & Gypsy Company \_\_\_\_\_  
 NORTH

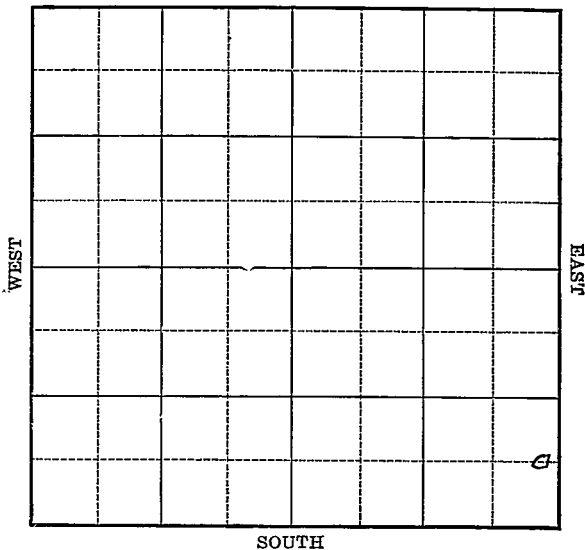

Location \_\_\_\_\_

Rig Up \_\_\_\_\_

Drilling Remarks

Drilling Remarks

\_\_\_\_\_  
 \_\_\_\_\_  
**RECORD**

**PRODUCTION**

Cased \_\_\_\_\_ in. \_\_\_\_\_ ft.  
 Sand \_\_\_\_\_  
 Gas \_\_\_\_\_  
 Oil \_\_\_\_\_  
 Total Depth \_\_\_\_\_

1st 24 hrs. Nat. \_\_\_\_\_  
 1st 24 hrs. after shot \_\_\_\_\_  
 Gas \_\_\_\_\_ cu. ft.  
 Dry Hole \_\_\_\_\_  
 Abandoned \_\_\_\_\_



Map No. 45 Sec. 35 Twp. 21 R. 7

Well No. 2 Armstrong

Selby & Gypney Company

Contractor

# COMPLETED SECTION PLAT

----- Ft. from N. Line

660 Ft. from S. Line

200 Ft. from E. Line

----- Ft. from W. Line  
*NO RECORD*

OWDD

			<u>0</u>

*Asset*

Location -----

Rig up -----

Drilling and Remarks:

P. B. to 2854

Inkq. very little water

G-39.2

## RECORD

Cased ----- in., ----- ft.

Sand -----

Gas -----

Oil 2762 - 2821

Total Depth 2944

## PRODUCTION

1st 24 hrs. Nat. 100

1st 24 hrs. after shot -----

Gas ----- Cu. Ft.

Dry Hole -----

Abandoned -----

Date

11/24 1925

G. W. G. Scout